

GENERAL NOTES



PRE-CONSTRUCTION MEETING AND CONSTRUCTION COMMENCEMENT:

- All construction methods and materials shall conform to the Construction Standards and Specifications of Roanoke County, the Western Virginia Water Authority, and the Virginia Department of Transportation.
- Stormwater Management Agreements with an attached 8 1/2" x 11" or 8 1/2" x 14" plan must be approved and recorded prior to the pre-construction meeting.
- Once all required items are submitted to Roanoke County, the developer must contact the Development Review Coordinator to indicate that a pre-construction meeting needs to be scheduled. The pre-construction meeting will be scheduled with the owner/developer two (2) working days later.
- All land disturbing projects that require approval of an erosion and sediment control plan, grading or clearing permit shall require that the applicant provide the name of an individual who will be responsible for land disturbing activities and that this individual hold a Responsible Land Disturber (RLD) Certificate from the Department of Environmental Quality. The Responsible Land Disturber can be anyone from the Project team that is certified by the Commonwealth of Virginia to be in charge of carrying out the land disturbing activity for the project.
- It is the responsibility of the owner/developer to notify the certified Responsible Land Disturber and the Utility Contractor to attend the pre-construction meeting.
- The Development Review Coordinator will schedule the pre-construction meeting with the County Review Engineer, the County Inspector, and the Western Virginia Water Authority and the Town of Vinton Public Works Department if applicable.
- An approved set of plans, Storm Water Pollution Prevention Plan (SWPPP), VSMP coverage letter, and all permits must be available at the construction site at all times.
- The developer and/or contractor shall supply all utility companies with copies of approved plans, advising them that all grading and installation shall conform to approved plans.
- The project engineer will inform the owner/developer verbally and in writing of the County's obligation to perform inspections on site. Everyone in the meeting will be required to sign a pre-construction checklist indicating their knowledge of Roanoke County's obligation to perform inspections on site.
- The Erosion Control Permit or Combined Erosion Control & VSMP Permit is given to the developer at the pre-construction meeting.
- Notify Roanoke County prior to beginning installation of ESC measures. The County will inspect initial installations to ensure compliance with approved plan prior to start of grading. The developer SHALL contact the project inspector 24 hours before beginning any grading or construction on the property.
- County inspectors must inspect storm drain / stormwater management / BMP installations during the process of installation. Please contact the site inspector 24 hours in advance.
- All work shall be subject to inspection by Roanoke County, the Western Virginia Water Authority and the Virginia Department of Transportation Inspectors.
- Contractors shall notify utilities of proposed construction at least two (2), but not more than ten (10) working days in advance. Area public utilities may be notified thru "Miss Utility": 1-800-552-7001 or VA 811.
- The 100 year Floodway shall be staked prior to any construction.
- Grade stakes shall be set for all curb and gutter, culvert, sanitary sewer and storm sewer at all times of construction.
- Roanoke County shall be notified when a spring is encountered during construction.
- Construction debris shall be containerized in accordance with the Virginia Litter Control Act. No less than one litter receptacle shall be provided on site.
- The contractor shall provide adequate means of cleaning mud from trucks and/or other equipment prior to entering public streets or rights of ways. It is the contractors responsibility to insure that the streets are in a clean, mud and dust free condition at all times.
- Plan approval in no way relieves the developer or contractors of the responsibilities contained within the erosion and sediment control or stormwater management policies.
- Field construction shall honor proposed drainage divides as shown on plans.
- Field corrections shall be approved by the Roanoke County and/or the Western Virginia Water Authority and the Professional of Record, prior to such construction.
- The developer or contractor shall supply the County and the Western Virginia Water Authority with correct As-Built plans before final acceptance.

VIRGINIA DEPARTMENT OF TRANSPORTATION:

- Plan approval by Roanoke County does not guarantee issuance of any permits by the Virginia Department of Transportation.
- A permit must be obtained from the Virginia Department of Transportation, Salem Residency Office prior to construction in the highway right-of-way.
- The preliminary pavement designs should be based on a predicted sub-grade CBR value of 7.0 and with a Resiliency Factor (RF) of 2.0 as shown in the current edition of the Virginia Department of Transportation Pavement Design Guide for Subdivision and Secondary Roads. The sub-grade soil is to be tested by an independent laboratory and the results submitted to the Virginia Department of Transportation prior to base construction. Should the sub-grade CBR value and/or the RF value be less than the predicted values, additional base material will be required in accordance with Departmental specifications. Refer to the same manual as the number and locations of the required soil samples to be tested. All pavement designs shall be submitted to the Department for review and approval. The sub-grade shall be approved by the Virginia Department of Transportation prior to placement of the base. Base shall be approved by the Virginia Department of Transportation for depth, template, and compaction before the surface is applied.
- Standard guardrail with safety end sections may be required on fills or in areas where hazards exist as deemed necessary. After completion of rough grading operations, the County Engineer and Virginia Department of Transportation shall be contacted to schedule a field review. Where guard rail is warranted, the standard shoulder width shall be provided and the guard rail shall be installed in accordance with the current edition of the VDOT Road and Bridge Standards as part of this development.
- Standard street and traffic control signs shall be erected at each intersection by the developer prior to final street acceptance.
- All traffic devices shall be in accordance with current edition of the "Manual on Uniform Traffic Control Devices" (MUTCD).
- All unsuitable material shall be removed from the construction limits of the roadway before placing embankment.

See Sheet **N/A** for Stormwater Site Statistics Table.
See Sheet **N/A** for New BMP Information Table.

The Project Engineer shall provide electronic copies of the approved plans to the Development Review Coordinator within 5 working days of the pre-construction meeting.
The notes on this sheet shall not be modified.

COUNTY OF ROANOKE, VA

(PUBLIC IMPROVEMENTS PROJECT, SURETY NOT APPLICABLE)

QUANTITY & COST ESTIMATE

ITEM	QUANTITY	UNIT	UNIT PRICE	COST	BONDABLE
CLEARING AND GRUBBING		AC			
EXCAVATION (ON-SITE)		C.Y.			
EMBANKMENT		C.Y.			
GRATE INLET DI-1		EA			
CURB INLET DI-		EA			
STORM DRAIN MANHOLE ASS'Y		EA			
MANHOLE MH-		EA			
15-IN. CONCRETE PIPE, CLASS III		LF			
18-IN. STORM PIPE, VDOT CL. III RCP OR DUAL WALL HDPE		LF			
36-IN. STORM PIPE, VDOT CL. III RCP OR DUAL WALL HDPE		LF			
-IN. C.M. CULVERT		LF			
-IN. C.M. CULVERT		LF			
BOX CULVERT		LS			
PAVED SWALE		LF			
RIPRAP - CLASS		SF			
PERMANENT GRASS SWALE		LF			
-IN. CONCRETE ENDWALL EW-		EA			
-IN. END SECTION ES-		EA			
STAND-UP CONCRETE CURBING CG-2		LF			
CURB & GUTTER CG-6		LF			
VALLEY GUTTER		EA			
GRAVEL BASE		SY			
GRAVEL SHOULDER		SY			
SURFACE TREATMENT		SY			
2-IN. BIT. CONC.: TYPE BM25.0		SY			
2-IN. BIT. CONC.: TYPE SM9.5A		SY			
1-1/2-IN. BIT. CONC.: TYPE SM9.5A		SY			
VDOT TYPE 21-A BASE STONE		C.Y.			
TRAFFIC BARRICADE		EA			
8" WATER LINE		LF			
6" WATER LINE		LF			
AIR RELEASE VALVES W/ VAULT, FRAME & COVER		EACH			
FIRE HYDRANT ASSEMBLIES		EA			
BLOW OFFS W/ VAULT, FRAME & COVER		EA			
8-IN. GATE VALVES, W/ VAULT, FRAME & COVER		EACH			
-IN. GATE VALVES, W/ VAULT, FRAME & COVER		EA			
8" SANITARY SEWER		LF			
STANDARD MANHOLE W/ FRAME & COVER		EA			
SAMPLING MANHOLE/PORT		EA			
LANDSCAPING		LS			
AMENITIES (INCLUDING BUT NOT LIMITED TO TRAILS, ETC..)		LS			
STORMWATER MANAGEMENT		LS			
AS-BUILT PLANS (STORM SEWER SYSTEMS)		LS			
AS-BUILT PLANS (STORMWATER MANAGEMENT)		LS			
SUBTOTAL					
10% CONTINGENCY					
ESTIMATED TOTAL					

BY SEALING THE PLANS, THE DESIGN PROFESSIONAL HEREBY CERTIFIES THAT THE FOREGOING ESTIMATE REFLECTS THE CURRENT IMPROVEMENT COSTS OF THIS PROJECT.

CALDWELL WHITE ASSOCIATES
ENGINEERS / SURVEYORS / PLANNERS
4203 MELROSE AVENUE
P.O. BOX 6260
ROANOKE, VIRGINIA 24017-0260
(540) 366-3400
FAX: (540) 366-3702

PLAN APPROVED
REVIEW COORDINATOR: *Denise L. White*
REVIEW COORDINATOR: *Denise L. White*

APPROVED

TULLY DRIVE / NEIL DRIVE STORM DRAIN PROJECT
FOR
ROANOKE COUNTY DEPARTMENT OF STORMWATER OPERATIONS
Situate Generally the intersection of Tully Drive and Neil Drive
Catawba Magisterial District
County of Roanoke, Virginia

SHEET C-01 OF 9

CONSTITUTION OF VIRGINIA
CORBIN L. WHITE
License No. 23843
04-01-2024
PROFESSIONAL ENGINEER

PROJECT DESCRIPTION

THE PURPOSE OF THIS PROJECT IS TO REMOVE SECTIONS OF EXISTING BITUMINOUS CURBING AND SAW-CUT EXISTING PAVEMENT FOR THE INSTALLATION OF NEW CONCRETE CURB & GUTTER, INSTALL ADDITIONAL STORM DRAIN INLET STRUCTURES AND PIPING, AND TO REPLACE CERTAIN RUNS OF EXISTING STORM DRAIN PIPE WITH LARGER DIAMETER PIPE.

EXPLORATORY EXCAVATIONS REQUIRED

DURING THE COURSE OF DESIGN, THE ENGINEER INITIATED MISS UTILITY TICKET NUMBER B223002105 FOR LOCATION OF UNDERGROUND UTILITIES. ALTHOUGH IT IS KNOWN THAT EACH DEVELOPED LOT IS SERVED BY A SANITARY SEWER LATERAL, ONLY A FEW IN THE WORK AREA WERE MARKED. THOSE THAT WERE MARKED WERE FIELD-LOCATED BY CWA. ADDITIONALLY, CWA FIELD LOCATED ANY SEWER CLEANOUTS THAT WERE VISIBLE, BUT NOT MARKED. AT THESE LOCATIONS WE HAVE ASSUMED THE LATERAL RUNS FROM THE CLEANOUT PERPENDICULAR TO THE SEWER MAIN.

DURING THE COURSE OF PLAN REVIEW, THE WVWA PROVIDED CWA WITH THE ORIGINAL 1961 'DEVELOPMENT PLAN' FOR THE GLEN COVE SUBDIVISION, WHICH SHOWED NEW SANITARY LATERAL ALIGNMENTS, WITH NO INFORMATION RELATIVE TO LATERAL SLOPE OR ELEVATION AT THE PROPERTY LINES. THESE APPROXIMATE SANITARY LATERAL LOCATIONS HAVE BEEN SHOWN HEREIN, SEE SHEET C-04. FOR VERTICAL ALIGNMENT OF THESE LATERALS, CWA ASSUMED THEY WERE INSTALLED FROM THE MAIN AT 2.08% SLOPE.

FOR THE MOST PART, THE ALIGNMENTS AND ELEVATIONS OF THE EXISTING SANITARY LATERALS DO NOT SEEM TO CONFLICT WITH THE PROPOSED WORK. HOWEVER, THERE ARE THREE (3) LOCATIONS WHERE THE SANITARY LATERAL LOCATIONS SHOWN ON THE 1961 DEVELOPMENT PLAN MAY BE EITHER TOO CLOSE HORIZONTALLY TO THE PROPOSED INLETS, OR MAY CONFLICT VERTICALLY WITH THE NEW STORM DRAIN PIPING. THE FIRST ACTIONS OF THE CONTRACTOR, FOLLOWING EXECUTION OF A MISS UTILITY TICKET BUT PRIOR TO INITIATING FABRICATION OF NEW STORM STRUCTURES, SHALL BE TO PERFORM EXPLORATORY EXCAVATIONS FOR THE FOLLOWING SANITARY SEWER LATERALS, TO CONFIRM LOCATION AND TO DETERMINE DEPTH OF LINE AT THE LOCATIONS INDICATED:

1. AT 2801 NEIL DRIVE, CONFIRM LOCATION AND ELEVATION OF EXISTING SANITARY LATERAL AT THE BACK OF CURB, OR AS NEAR AS POSSIBLE GIVEN LOCATIONS OF OTHER UTILITIES. AVAILABLE RECORDS INDICATE THIS LATERAL MAY CONFLICT VERTICALLY WITH NEW STORM DRAIN PIPING, AND MAY LIE TOO CLOSE (< 4') HORIZONTALLY TO THE PROPOSED CURB INLET.
2. AT 2804 NEIL DRIVE, CONFIRM LOCATION AND ELEVATION OF EXISTING SANITARY LATERAL AT THE BACK OF CURB, OR AS NEAR AS POSSIBLE GIVEN LOCATIONS OF OTHER UTILITIES. AVAILABLE RECORDS INDICATE THIS LATERAL MAY LIE TOO CLOSE (< 4') HORIZONTALLY TO THE PROPOSED CURB INLET.
3. AT 2804 TULLY DRIVE, CONFIRM LOCATION AND ELEVATION OF EXISTING SANITARY LATERAL AT THE BACK OF CURB, OR AS NEAR AS POSSIBLE GIVEN LOCATIONS OF OTHER UTILITIES. AVAILABLE RECORDS INDICATE THIS LATERAL MAY LIE TOO CLOSE (< 4') HORIZONTALLY TO THE PROPOSED CURB INLET.

UPON PERFORMING THE EXPLORATORY EXCAVATIONS, CONTRACTOR SHALL PROVIDE THE OWNER AND ENGINEER WITH THE RESULTS, AND THE ENGINEER WILL DETERMINE WHETHER FIELD REVISIONS ARE REQUIRED FOR EITHER HORIZONTAL PLACEMENT OF NEW STRUCTURES, OR VERTICAL REVISIONS TO INVERTS OF NEW PIPES AND STRUCTURES.

ENGINEER'S NOTES

CALDWELL WHITE ASSOCIATES ASSUMES NO RESPONSIBILITY FOR ADEQUACY OF PLANS OR FOR INFORMATION ON PLANS UNTIL SUCH PLANS HAVE BEEN APPROVED BY THE REQUIRED PUBLIC AGENCIES.

ANY WORK COMMENCED ON A PROJECT PRIOR TO PLAN APPROVAL IS AT SOLE RISK OF THE DEVELOPER.

CALDWELL WHITE ASSOCIATES DOES NOT GUARANTEE THE COMPLETION OR QUALITY OF PERFORMANCE OF THE CONTRACTS BY CONTRACTORS OR OTHER THIRD PARTIES.

ALL TRENCHING AND EXCAVATION SHALL BE PERFORMED IN STRICT ACCORDANCE WITH OSHA RULES AND REGULATIONS PERTAINING THERETO.

GRADING, COMPACTION AND FINISH SURFACE NOTES

FINISH GRADE FOR NEW CURB & GUTTER SHALL BE ESTABLISHED BY USING TOP OF EXISTING PAVEMENT ELEVATIONS AS THE FINISH ELEVATION OF THE FREE EDGE OF THE NEW GUTTER PAN. IN THE AREA WHERE STORM DRAIN REPLACEMENT IS IN THE REAR & SIDE YARDS OF THE RESIDENCES, FINISH GRADE SHALL MATCH EXISTING.

ALL DENUDED AREAS SHALL BE PERMANENTLY SEEDED WITHIN SEVEN (7) DAYS OF REACHING FINAL GRADE. TEMPORARY SEEDING SHALL BE APPLIED, WITHIN SEVEN (7) DAYS, TO DENUDED AREAS NOT AT FINAL GRADE BUT THAT WILL REMAIN UNDISTURBED FOR MORE THAN 14 DAYS.

PERMANENT VEGETATIVE COVER SHALL BE ESTABLISHED ON ALL DENUDED AREAS NOT OTHERWISE PERMANENTLY STABILIZED.

A MINIMUM OF 4" OF TOPSOIL SHALL BE PLACED IN ALL AREAS TO RECEIVE PERMANENT SEEDING OR AREAS OF NEW LANDSCAPING.

ALL STRUCTURAL FILL SHALL BE COMPACTION TO 98% OF STANDARD PROCTOR (ASTM D698). STRUCTURAL FILL IS DEFINED AS ANY AREA WITHIN 5' HORIZONTALLY OF ANY BUILDING, ROAD, WALK, OR OTHER HARD SURFACE, PROPOSED OR FUTURE.

AREAS OF LANDSCAPING OR OTHER NON-STRUCTURAL USES SHALL BE COMPACTION TO MINIMUM 80% OF STANDARD PROCTOR.

UNLESS OTHERWISE DIRECTED BY THE OWNER, ALL WORK PERFORMED IS UNCLASSIFIED, AND THE CONTRACTOR IS REQUIRED TO PERFORM CUT / FILL OPERATIONS NECESSARY TO PERFORM HIS TRADE.

TRAFFIC CONTROL AND SAFETY

ALTHOUGH FULL-WIDTH STREET CLOSURES SHALL BE AVOIDED WHENEVER POSSIBLE, TULLY DRIVE AND NEIL DRIVE FORM A LOOP, AND THEREFORE PERIMETER ACCESS WILL BE AVAILABLE TO RESIDENTS AND VISITORS SHOULD FULL-WIDTH TEMPORARY CLOSURES BE UNAVOIDABLE.

THE CONTRACTOR SHALL COORDINATE CLOSELY WITH THE COUNTY OF ROANOKE AND VIRGINIA DEPARTMENT OF TRANSPORTATION RELATIVE TO PROVIDING TEMPORARY TRAFFIC CONTROL MEASURES AND SCHEDULING PARTIAL TRAVELWAY CLOSURES, PARTICULARLY RELATIVE TO THE WORK THAT IS REQUIRED FOR THE NEW STORM DRAIN CONSTRUCTION. TEMPORARY CONSTRUCTION BARRIERS SHALL BE IN PLACE AT ALL TIMES TO PHYSICALLY SEPARATE THE CONSTRUCTION AREA FROM THE PUBLIC.

THE CONTRACTOR SHALL PROVIDE TRAFFIC CONTROL BARRELS, CONES, ETC. TO ENSURE THE SAFETY OF RESIDENTS, VISITORS, AND CONSTRUCTION PERSONNEL.

PROVIDE PROPERTY OWNERS A MINIMUM 48 HOURS NOTICE PRIOR TO RESTRICTING RESIDENTS' ACCESS TO THEIR DRIVEWAYS.

VIRGINIA DEPARTMENT OF TRANSPORTATION NOTES


THE CONTRACTOR WILL BE REQUIRED TO OBTAIN A LAND USE PERMIT AND POST APPLICABLE SURETY FROM VDOT. ADDITIONAL INFORMATION RELATIVE TO TRAFFIC CONTROL PLANS MAY BE REQUIRED AT THAT TIME.

ALL PERMITS & FEES WILL BE THE RESPONSIBILITY OF THE CONTRACTOR.

WESTERN VIRGINIA WATER AUTHORITY NOTES

THE CONTRACTOR SHALL COORDINATE CLOSELY WITH THE WESTERN VIRGINIA WATER AUTHORITY RELATIVE TO RELOCATION OF EXISTING WATER METER BOXES AND LATERALS, SEE KEY NOTES, SHEETS C-03 AND C-04.

SHOULD UNFORESEEN CIRCUMSTANCES CAUSE ANY WORK TO BE PERFORMED RELATIVE TO SANITARY SEWER, SUCH WORK MUST BE REVIEWED AND APPROVED BY THE WESTERN VIRGINIA WATER AUTHORITY, PRIOR TO ANY SUCH WORK COMMENCING.

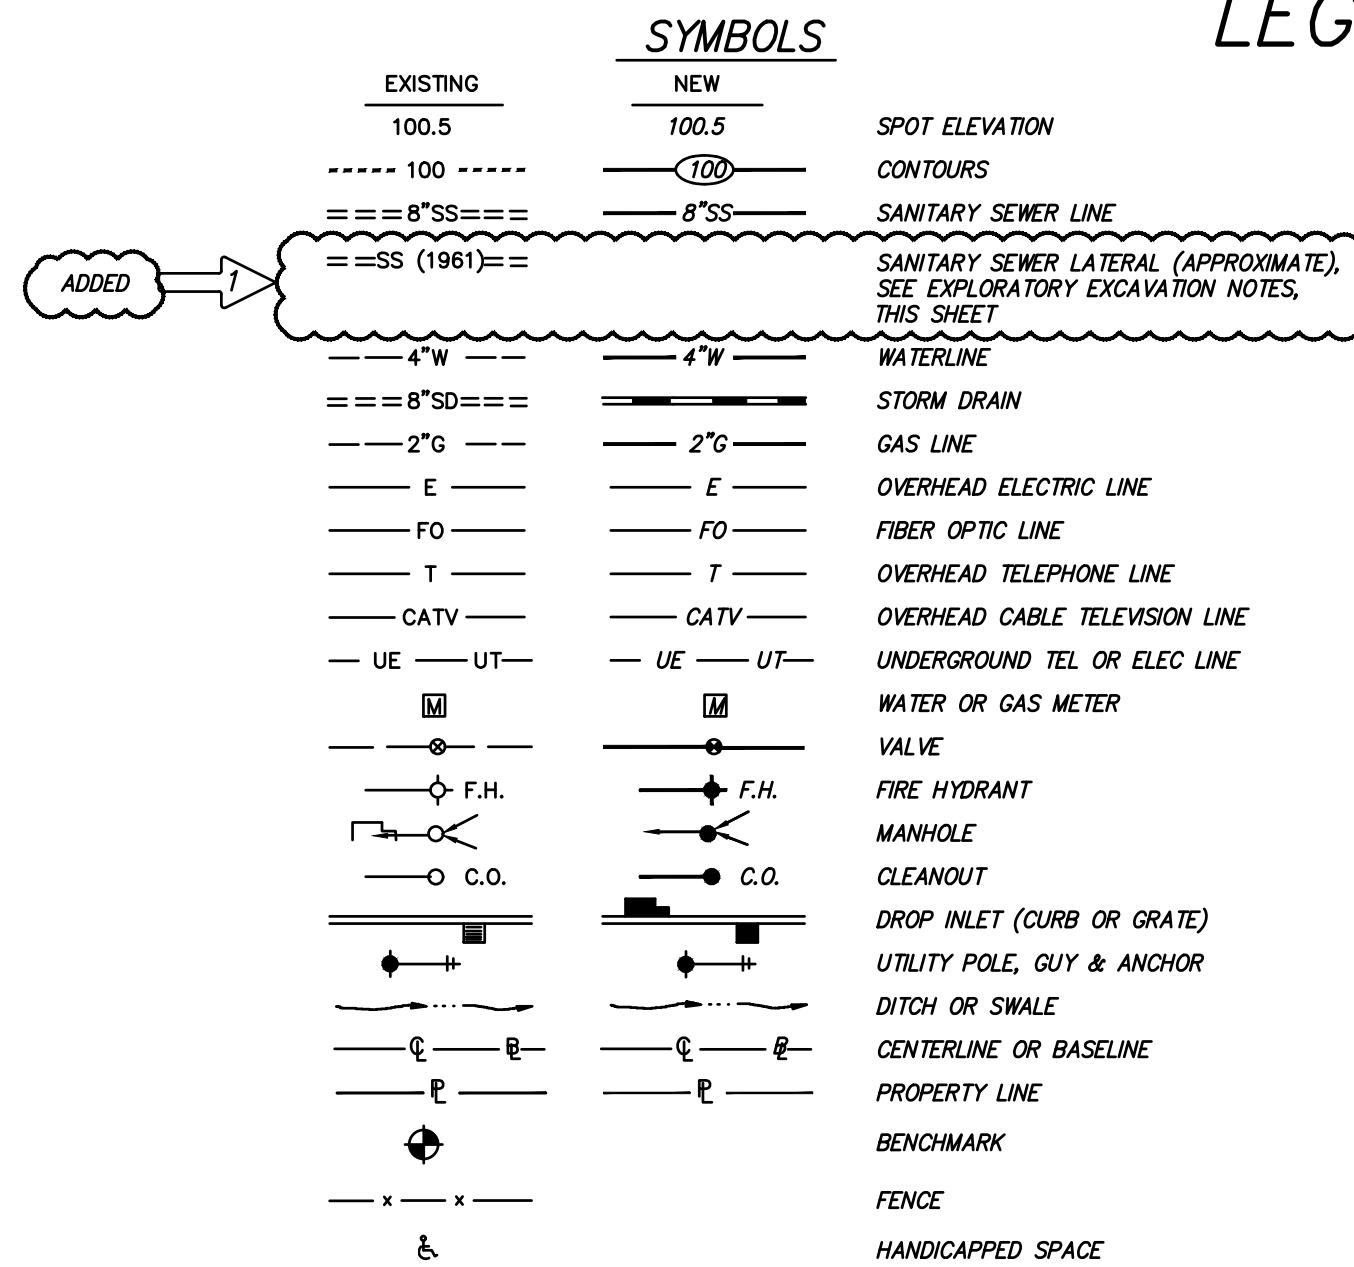

LEGEND

ABBREVIATIONS

AHFF	ARROW HEAD TOP OF FIRE HYDRANT	MIN	MINIMUM
APPROX	APPROXIMATE	MON	MONUMENT
ASPH	ASPHALT	PVMT	PAVEMENT
BC	BOTTOM OF CURB	R/W	RIGHT OF WAY
BIT	BITUMINOUS	REQD	REQUIRED
BLDG	BUILDING	SAN	SANITARY
BM	BENCHMARK	SS	SANITARY SEWER
C&G	CURB & GUTTER	STA	STATION
CMP	CORRUGATED METAL PIPE	STD	STANDARD
CONC	CONCRETE	TBM	TEMPORARY BENCHMARK
DI	DROP INLET	TC	TOP OF CURB
DIA	DIA	TEL	TELEPHONE
ELEC	ELEC	TYP	TYPICAL
FO	FIBER OPTIC LINE	UTPB	UNDERGROUND TELEPHONE PULL BOX
FOB	ELEVATION	VDOT	VIRGINIA DEPARTMENT OF TRANSPORTATION
FOPB	EXISTING	VERT	VERTICAL
HPT	FINISHED FLOOR		
INV	EDGE OF PAVEMENT		
IP	OVERHEAD ELECTRIC LINE		
MBL	OVERHEAD CABLE TELEVISION LINE		
MH	UNDERGROUND TEL OR ELEC LINE		
	WATERLINE		
	MANHOLE		
	CLEANOUT		
	DROP INLET (CURB OR GRATE)		
	UTILITY POLE, GUY & ANCHOR		
	DITCH OR SWALE		
	CENTERLINE OR BASELINE		
	PROPERTY LINE		
	BENCHMARK		
	FENCE		
	HANDICAPPED SPACE		

Revised August 23, 2023 Per 1st Municipal Review - C.L. White

NOTES AND LEGEND


FOR TULLY DRIVE / NEIL DRIVE STORM DRAIN PROJECT

PERFORMED FOR ROANOKE COUNTY DEPARTMENT OF


STORMWATER OPERATIONS

CATAWBA MAGISTERIAL DISTRICT

COUNTY OF ROANOKE, VIRGINIA

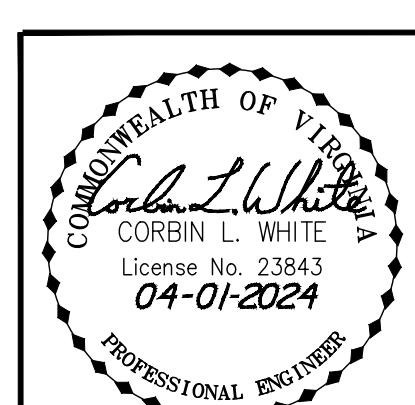

CL White
Caldwell White Associates
Engineers / Surveyors / Planners
4200 Melrose Avenue
P.O. Box 6260
Roanoke, Virginia 24017-0260
(540) 366-3400
Fax: (540) 366-8702

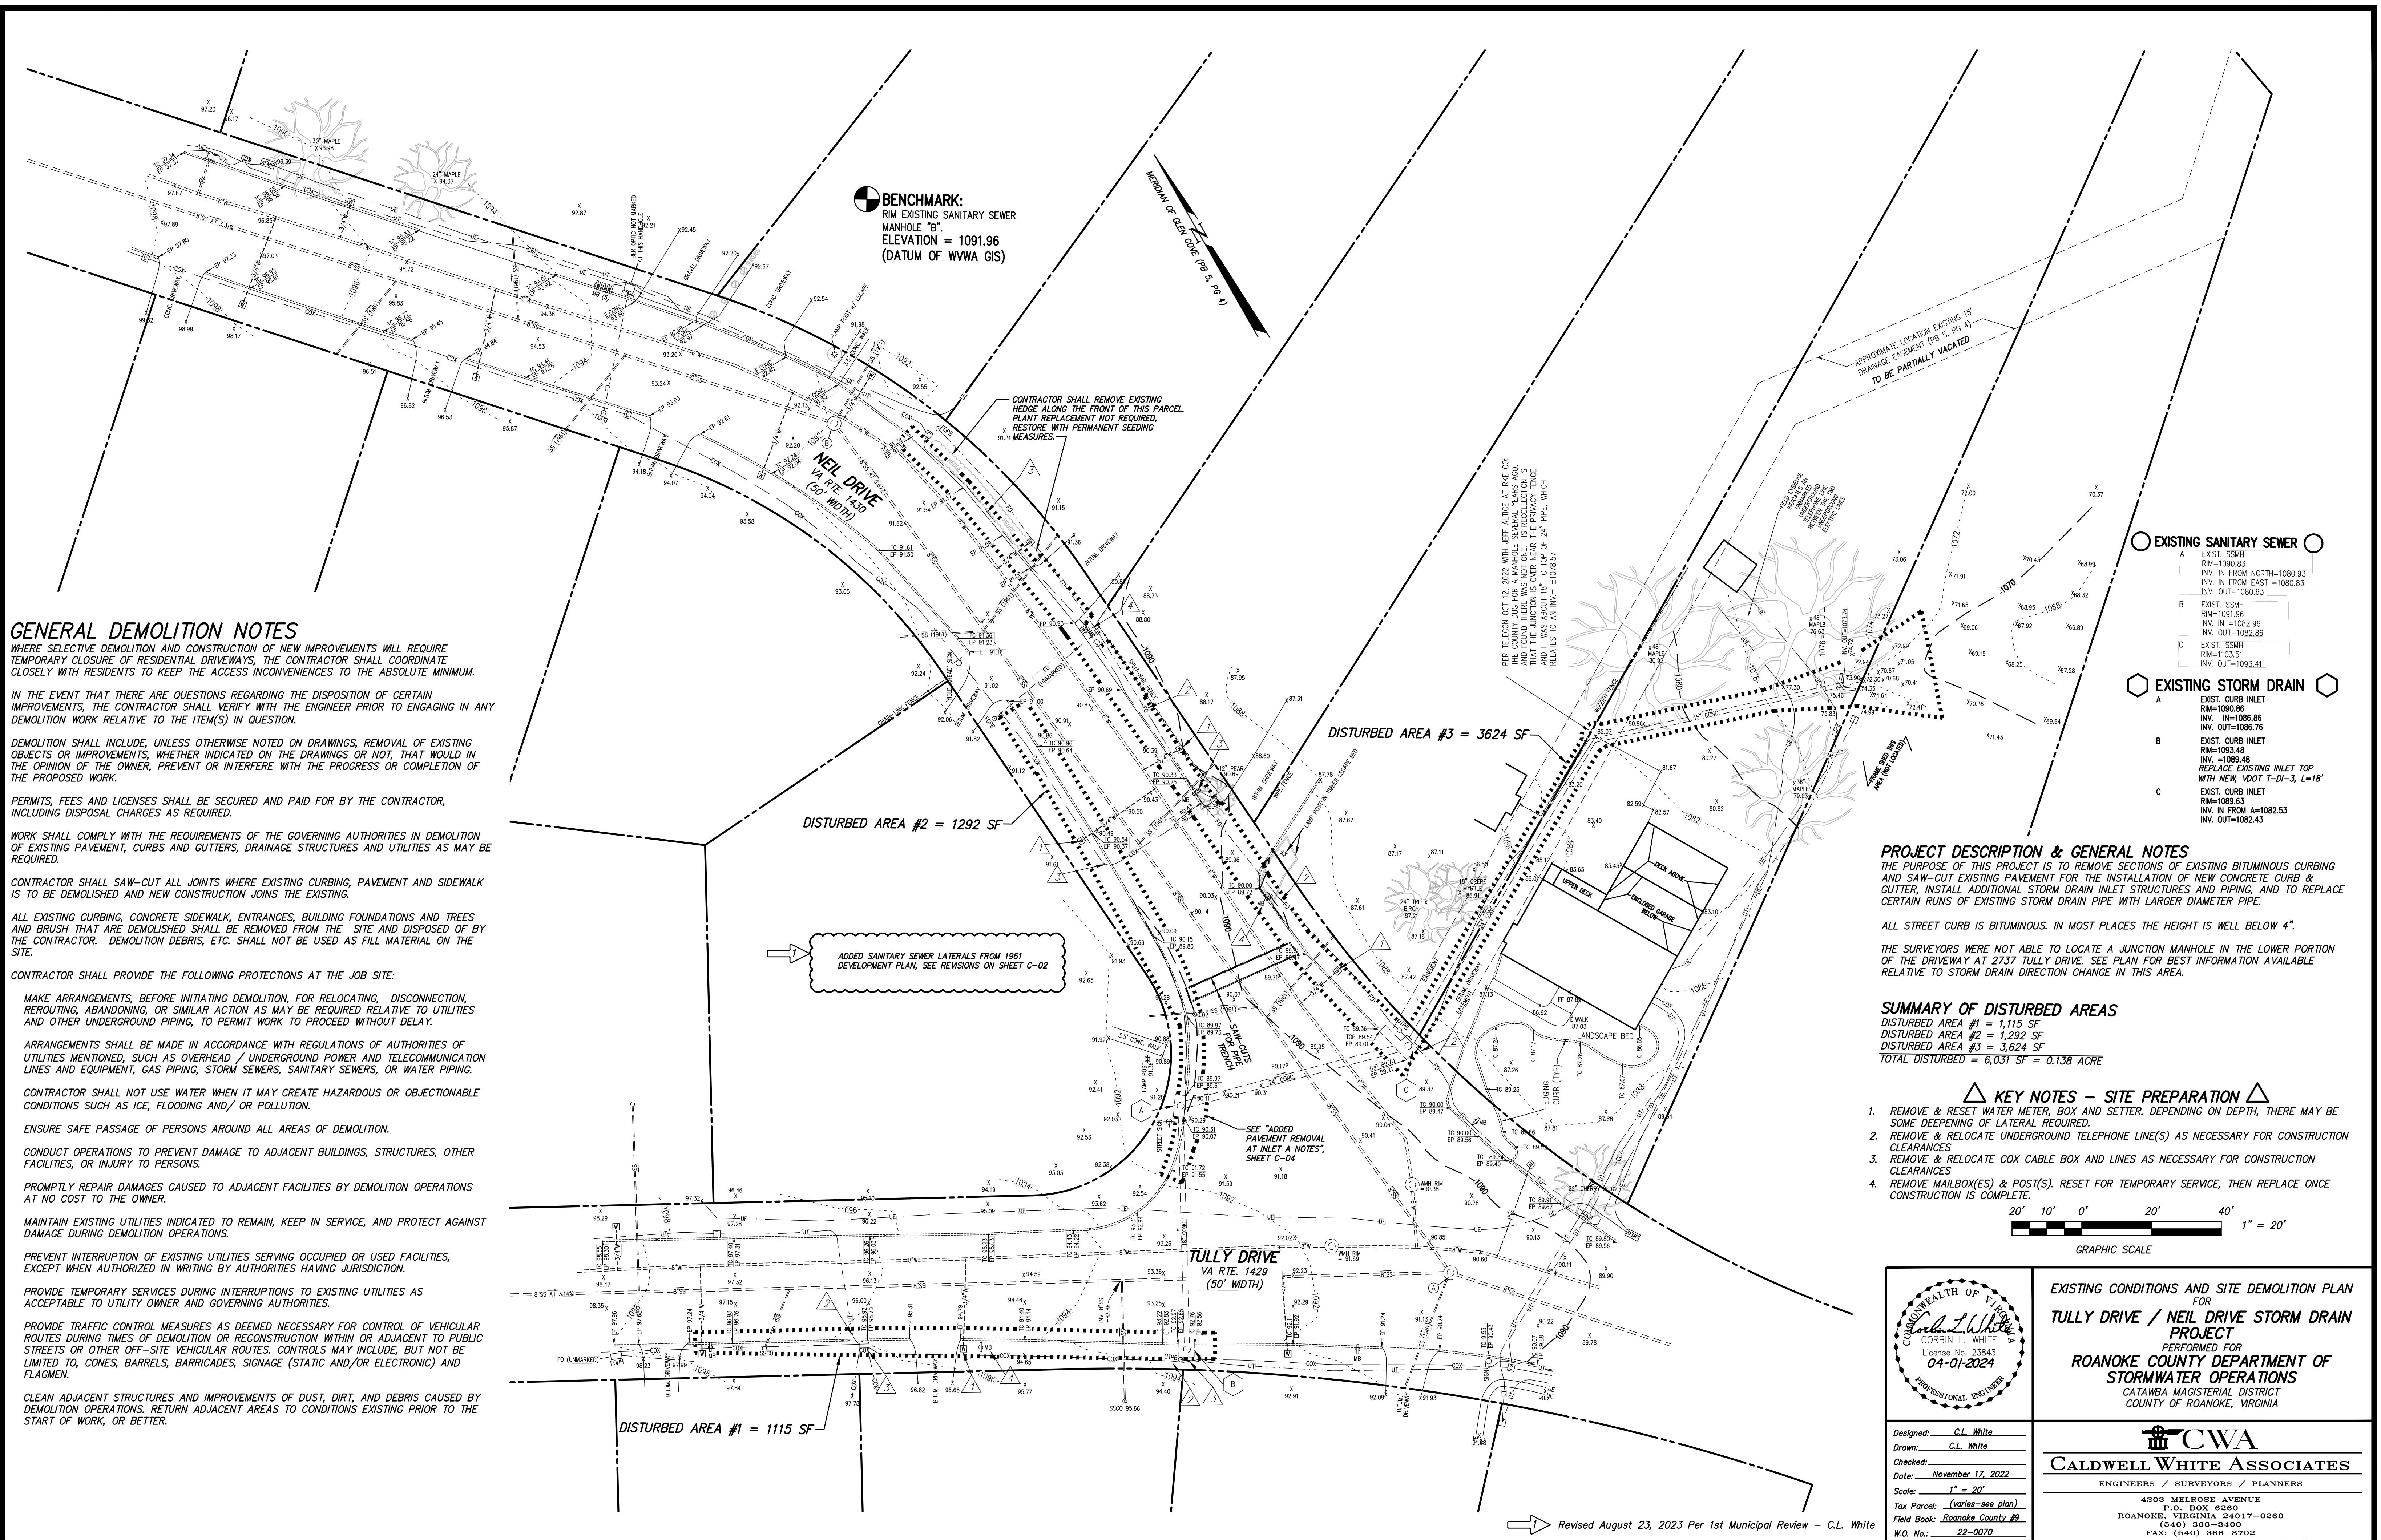

Revised August 23, 2023 Per 1st Municipal Review - C.L. White

ADDED PAVEMENT REMOVAL AT INLET A NOTES

UNDER EXISTING CONDITIONS, IT APPEARS THAT THE PAVEMENT IN THE VICINITY OF EXISTING INLET A WILL BE APPROXIMATELY 6" HIGHER THAN THE FREE EDGE OF THE NEW CG-6 CURB & GUTTER. AS SUCH, THE CONTRACTOR SHALL INCLUDE TIME AND MATERIALS TO REMOVE AND REPLACE ± 10 SY OF FULL DEPTH PAVEMENT, TO SMOOTHLY TRANSITION FROM EXISTING PAVEMENT GRADES TO NEW FREE EDGE OF GUTTER PAN.

△ NEW 2,142 SQ. FT. (0.0492 AC.) DRAINAGE EASEMENT, BOUNDED BY CORNERS 1 THROUGH 7 INCLUSIVE, TO 1

1 to 2	S 72° 14' 13" E	61.68'
2 to 3	N 85° 08' 35" E	11.37'
3 to 4	N 85° 08' 35" E	13.98'
4 to 5	S 17° 45' 47" W	39.50'
5 to 6	N 54° 35' 45" W	32.17'
6 to 7	N 72° 14' 13" W	72.08'
7 to 1	N 59° 12' 00" E	26.68'

3 to 6 (TIE ONLY) = 30.15'

NEW 1,427 SQ. FT. (0.0328 AC.) DRAINAGE EASEMENT ACROSS LOT 5, BOUNDED BY CORNERS 1 to 2 to 3 to 6 to 7 to 1.

NEW 715 SQ. FT. (0.0164 AC.) DRAINAGE EASEMENT ACROSS LOT 6, BOUNDED BY CORNERS 3 to 4 to 5 to 6 to 3.

ADDED NEW EASEMENT TABLE AND EASEMENT ON PLAN

STORM DRAIN REQUIREMENTS

ALL NEW STORM DRAIN STRUCTURES SHALL BE PRE-CAST CONCRETE. ALL STORM DRAIN MATERIALS, FABRICATION, AND INSTALLATION SHALL BE IN ACCORDANCE WITH VDOT STANDARDS AND SPECIFICATIONS.

ALL NEW STORM DRAIN STRUCTURES SHALL INCLUDE VDOT STD. IS-1 INLET SHAPING.

NEW STORM DRAIN PIPE SHALL BE VDOT CLASS III REINFORCED CONCRETE PIPE. ALL STORM DRAIN SHALL BE BEDDED IN ACCORDANCE WITH VDOT STD PB-1.

IN ACCORDANCE WITH THE ROANOKE COUNTY STORMWATER MANAGEMENT DESIGN MANUAL, BEDDING MATERIAL AND INSTALLATION SHALL COMPLY WITH THE REQUIREMENTS OF THE VDOT SPECIFICATIONS. USE CLASS I BACKFILL (CRUSHER-RUN OR VDOT #21) UP TO THE SPRING LINE FOR RCP. VDOT #57 STONE IS NOT ALLOWED AS PIPE BEDDING.

PROVIDE ADDITIONAL TEMPORARY COVER ON ALL NEW STORM DRAIN AS REQUIRED BY VDOT STD PC-1.

STRUCTURES

PIPES

A	EXIST. CURB INLET	100-B	PROVIDE 102.8' NEW 15" RCP AT 2.0%
	RIM=1090.86	INV. IN=1091.73	INV. OUT=1086.86
	INV. OUT=1086.76		
B	EXIST. CURB INLET	101-102	PROVIDE 81.7' NEW 18" RCP AT 1.80%
	RIM=1093.48	INV. IN=1086.10	INV. OUT=1084.63
	INV. OUT=1089.48		
C	REPLACE EXISTING INLET TOP WITH VDOT STD. IS-1 18". NEW INV. IN = 1089.58 (CONTRACTOR MAY CORE OR REMOVE AND REPLACE INLET BASE)	102-104	PROVIDE 40.3' NEW 24" RCP AT 7.52%
	INV. IN=1089.58	INV. IN=1084.53	INV. OUT=1081.50
	INV. OUT=1089.58		
	REPLACE EXISTING INLET TOP WITH VDOT STD. IS-1 18". NEW INV. IN = 1089.58 (CONTRACTOR MAY CORE OR REMOVE AND REPLACE INLET BASE)	103-104	PROVIDE 89.3' NEW 15" RCP AT 1.90%
	INV. IN=1089.58	INV. IN=1086.38	INV. OUT=1084.68
	INV. OUT=1089.58		
	REPLACE EXISTING INLET TOP WITH VDOT STD. IS-1 18". NEW INV. IN = 1089.58 (CONTRACTOR MAY CORE OR REMOVE AND REPLACE INLET BASE)	104-C	PROVIDE 41.6' NEW 24" RCP AT 2.00%
	INV. IN=1089.58	INV. IN=1081.40	INV. OUT=1080.57
	INV. OUT=1089.58		
	REPLACE EXISTING INLET TOP WITH VDOT STD. IS-1 18". NEW INV. IN = 1089.58 (CONTRACTOR MAY CORE OR REMOVE AND REPLACE INLET BASE)	105-OUT	PROVIDE 103.6' NEW 30" RCP AT 4.60%
	INV. IN=1089.58	INV. IN=1080.47	INV. OUT=1073.70
	INV. OUT=1089.58		
	REPLACE EXISTING INLET TOP WITH VDOT STD. IS-1 18". NEW INV. IN = 1089.58 (CONTRACTOR MAY CORE OR REMOVE AND REPLACE INLET BASE)	105-OUT	PROVIDE 72.5' NEW 30" RCP AT 2.54%
	INV. IN=1089.58	INV. IN=1075.73	INV. OUT=1073.76
	INV. OUT=1089.58		
100	PROVIDE NEW VDOT STD DI-3B, L=14' RIM=1096.40 INV. IN=1091.73	PROVIDE NEW VDOT STD DI-3B, L=14' RIM=1091.70 INV. IN=1086.10	PROVIDE NEW VDOT STD DI-3B, L=14' RIM=1090.86 INV. IN=1089.58
101	PROVIDE NEW VDOT STD DI-3B, L=14' RIM=1091.70 INV. IN=1086.10	PROVIDE NEW VDOT STD DI-3B, L=14' RIM=1090.86 INV. IN=1089.58	PROVIDE NEW VDOT STD DI-3B, L=14' RIM=1090.86 INV. IN=1089.58
102	PROVIDE NEW VDOT STD DI-3B, L=14' RIM=1090.86 INV. IN=1089.58 INV. OUT=1084.53	PROVIDE NEW VDOT STD DI-3B, L=14' RIM=1090.86 INV. IN=1089.58 INV. OUT=1084.53	PROVIDE NEW VDOT STD DI-3B, L=14' RIM=1090.86 INV. IN=1089.58 INV. OUT=1084.53
103	PROVIDE NEW VDOT STD DI-3B, L=14' RIM=1091.05 INV. IN=1086.38	PROVIDE NEW VDOT STD DI-3B, L=14' RIM=1091.05 INV. IN=1086.38	PROVIDE NEW VDOT STD DI-3B, L=14' RIM=1091.05 INV. IN=1086.38
104	PROVIDE NEW VDOT STD DI-3B, L=10' RIM=1089.85 INV. IN=1081.50 INV. OUT=1084.68	PROVIDE NEW VDOT STD DI-3B, L=10' RIM=1089.85 INV. IN=1081.50 INV. OUT=1084.68	PROVIDE NEW VDOT STD DI-3B, L=10' RIM=1089.85 INV. IN=1081.50 INV. OUT=1084.68
105	PROVIDE NEW VDOT STD STORM MANHOLE RIM=1082.07 INV. IN=1075.70 INV. OUT=1075.60	PROVIDE NEW VDOT STD STORM MANHOLE RIM=1082.07 INV. IN=1075.70 INV. OUT=1075.60	PROVIDE NEW VDOT STD STORM MANHOLE RIM=1082.07 INV. IN=1075.70 INV. OUT=1075.60

STORMWATER MANAGEMENT - WATER QUALITY

AS THIS PROJECT IS A LINEAR UTILITY PROJECT WITH LESS THAN 1 ACRE OF TOTAL LAND DISTURBANCE, THERE ARE NO REQUIREMENTS FOR PHOSPHORUS REMOVAL OR VSMP PERMITTING.

STORMWATER MANAGEMENT - QUANTITY

AS GROUND COVERS UNDER PRE- AND POST-DEVELOPMENT CONDITIONS WILL NOT RESULT IN AN INCREASE IN IMPERVIOUS SURFACES, AND STORMWATER FLOW TIMES WILL NOT BE APPRECIABLY ALTERED, RUNOFF ON ANY GIVEN DESIGN STORM WILL REMAIN UNCHANGED. THEREFORE NO STORMWATER MANAGEMENT STORAGE FACILITIES ARE WARRANTED.

DISTURBED AREA #2 = 1292 SF

DISTURBED AREA #3 = 3624 SF

1

2

3


86

87

88




89

90

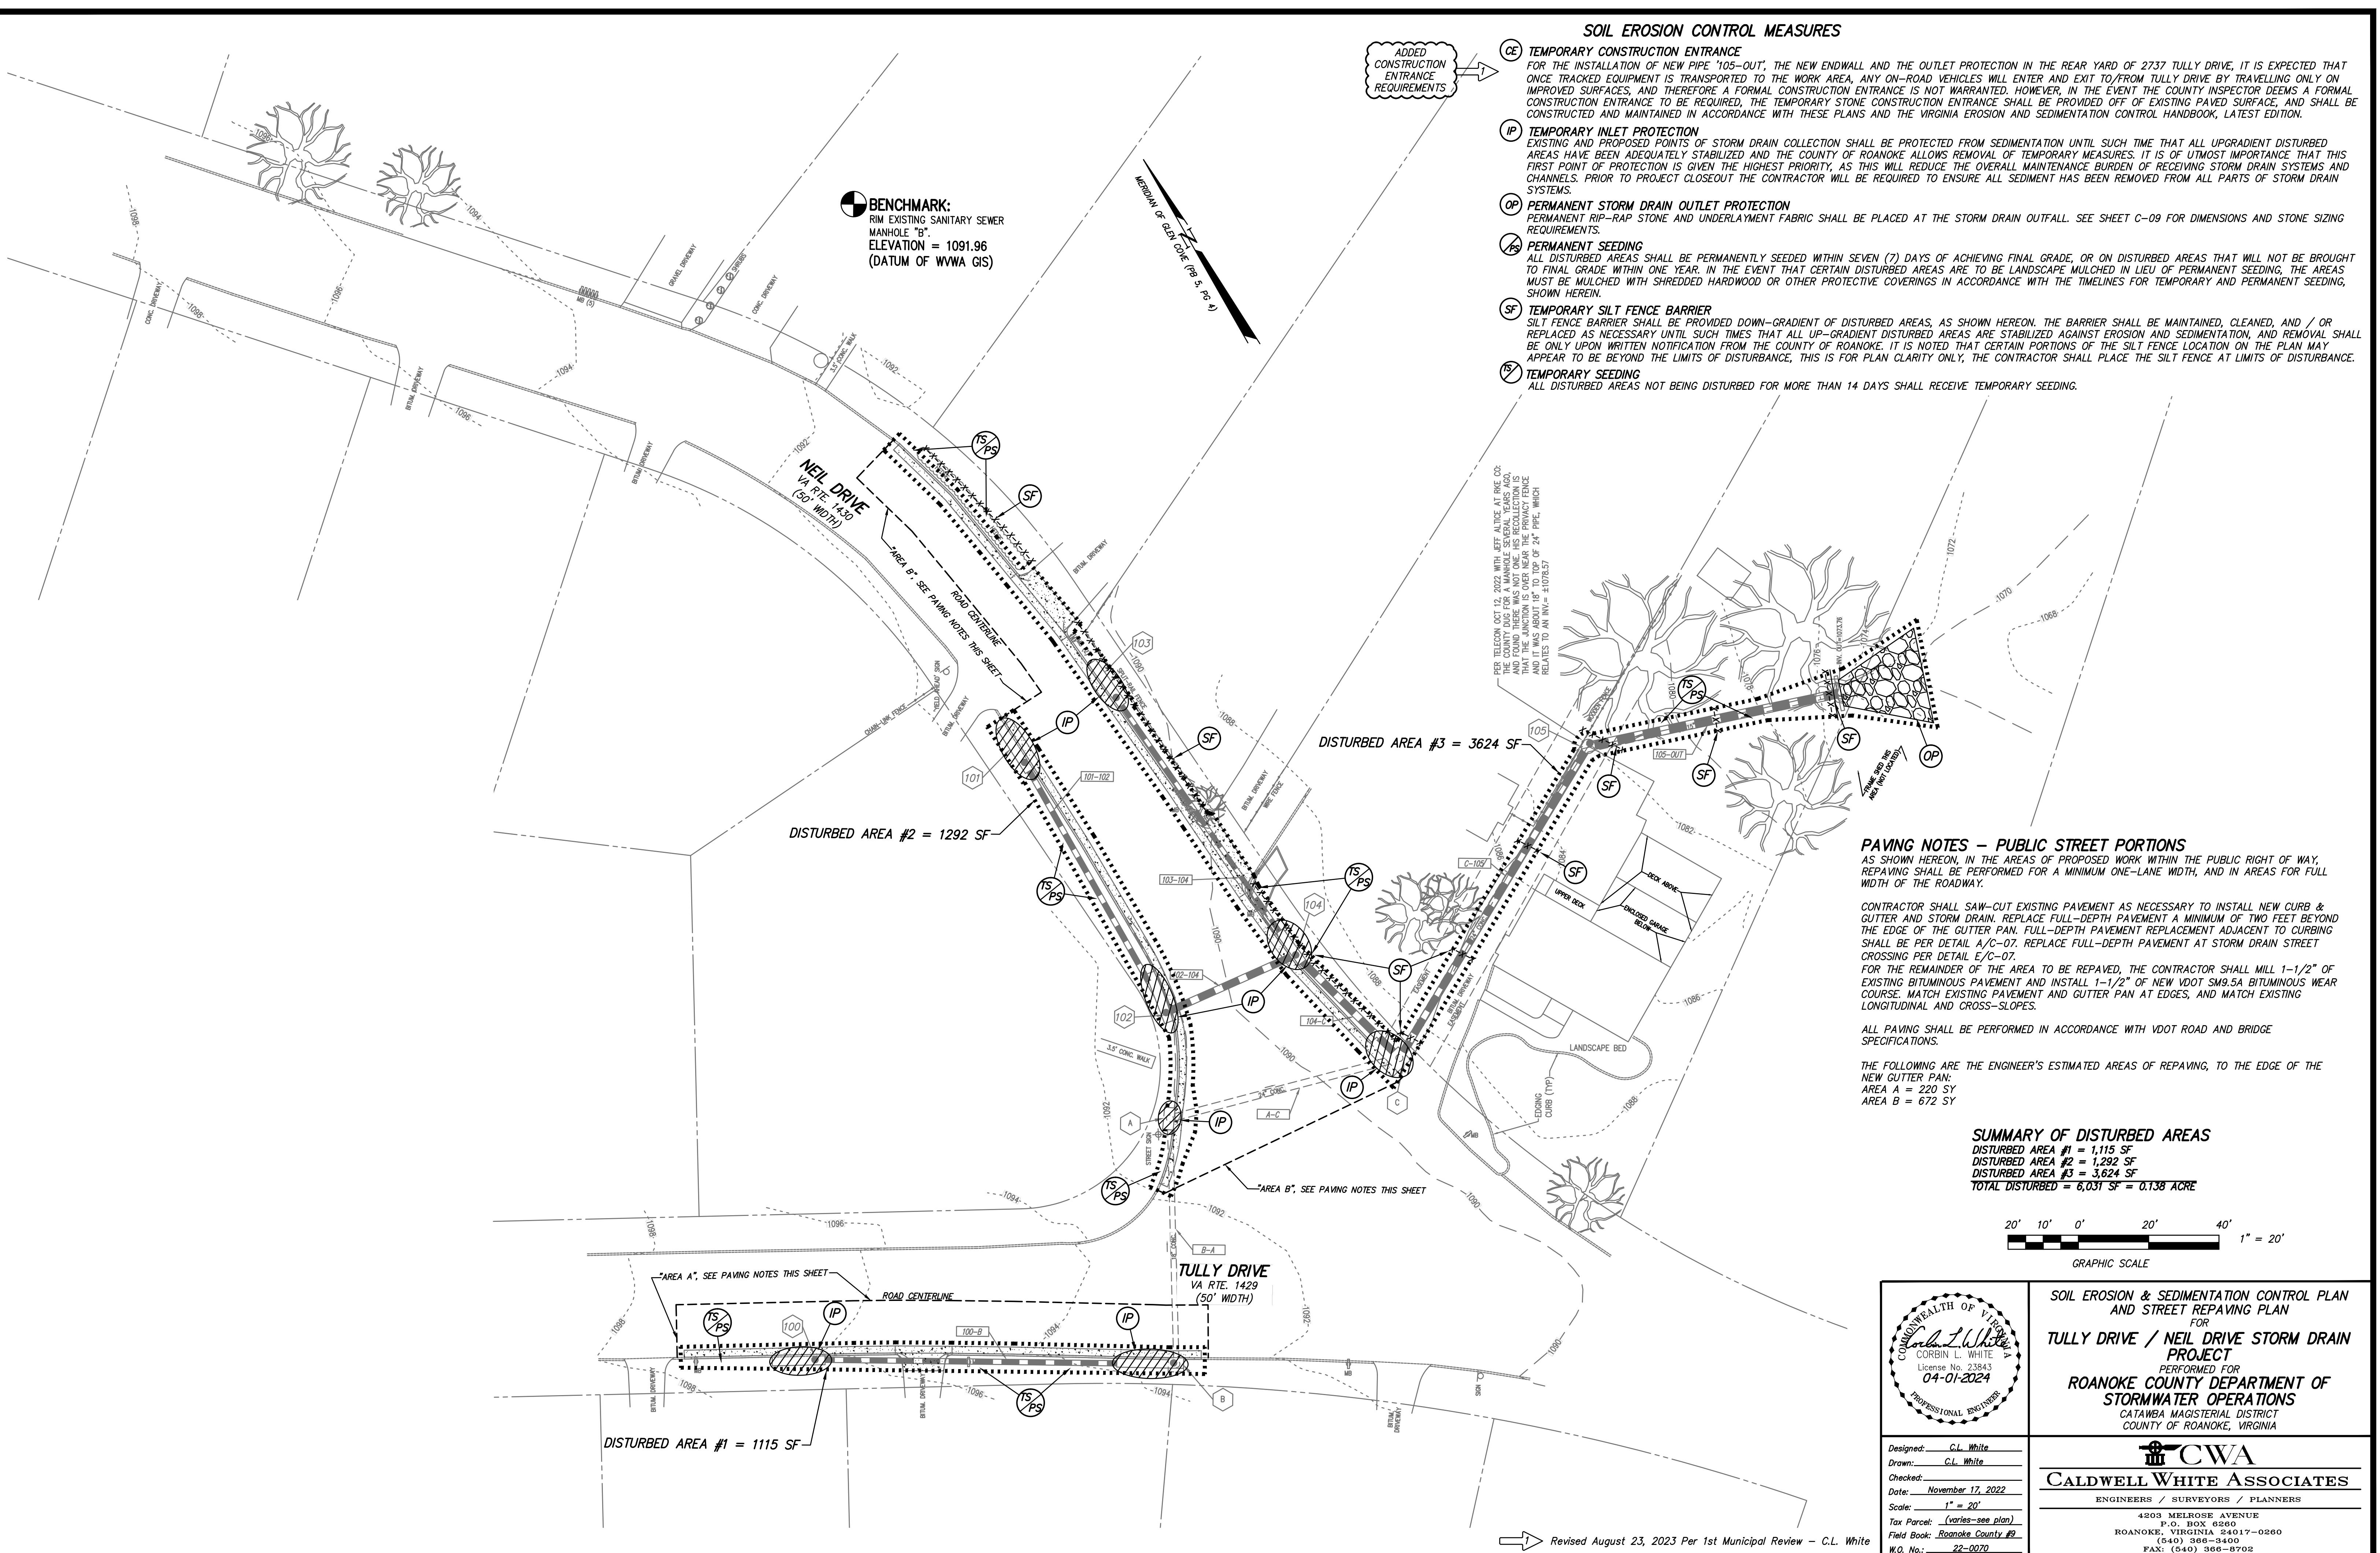


1 Revised August 23, 2023 Per 1st Municipal Review – C.L. White

APPROVED, 8/7/2024

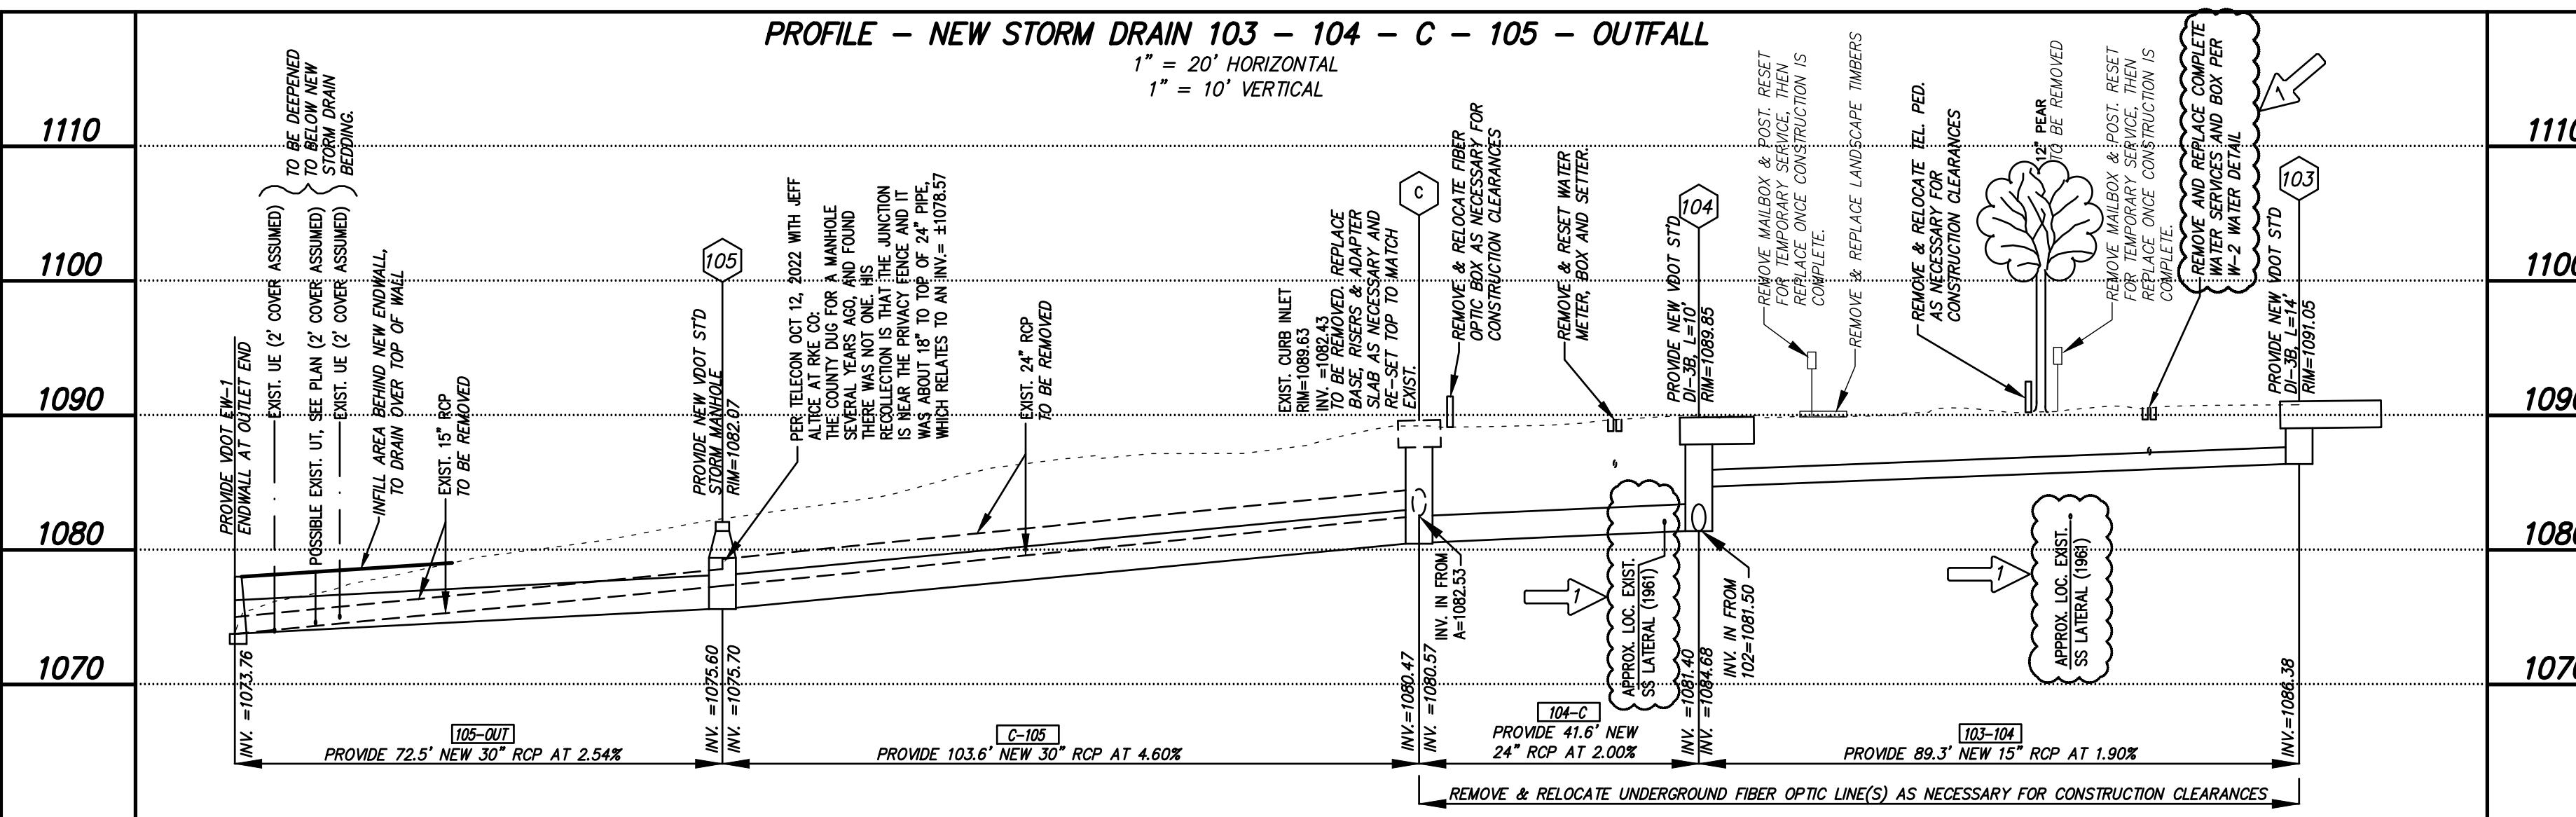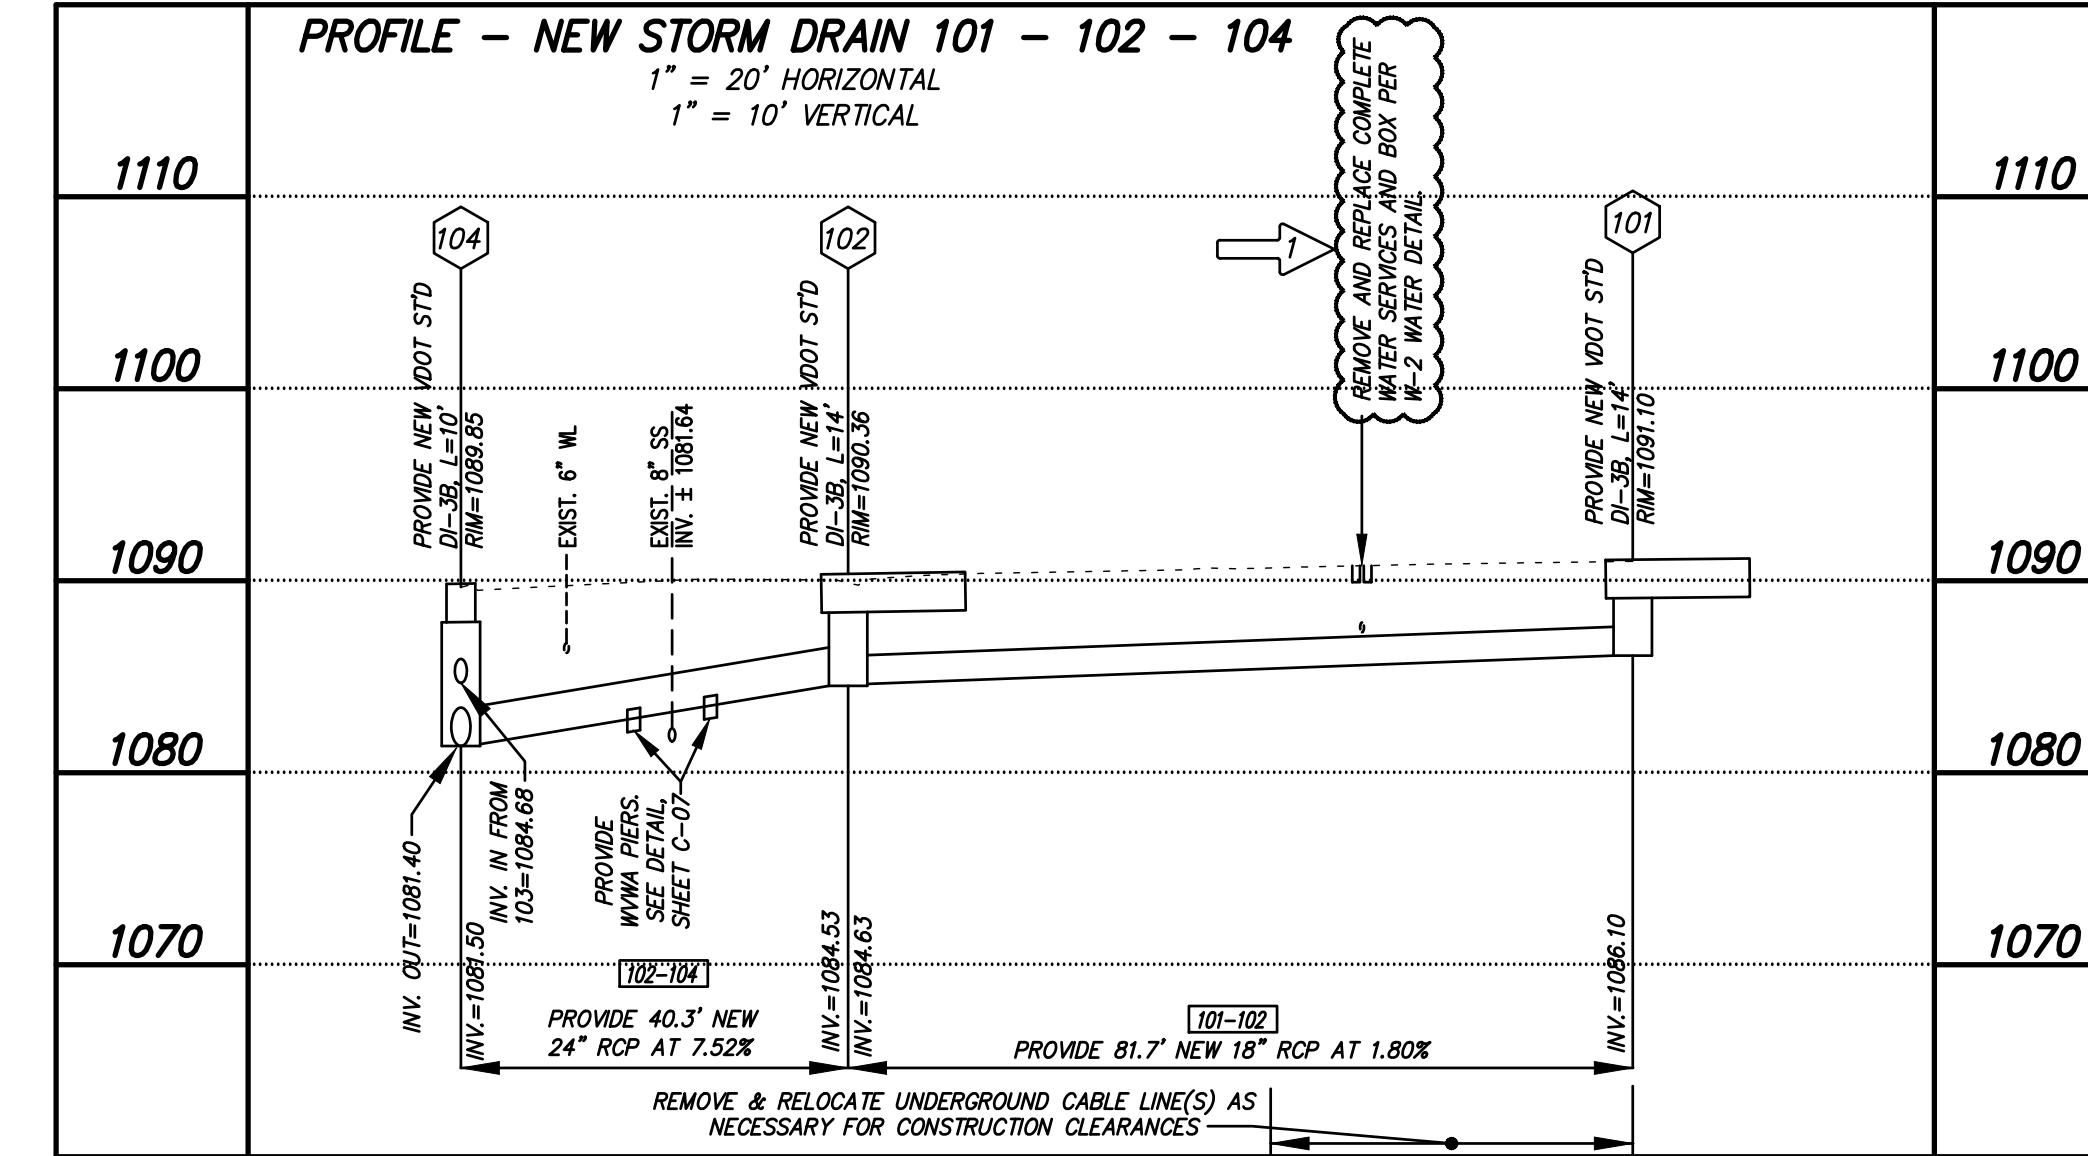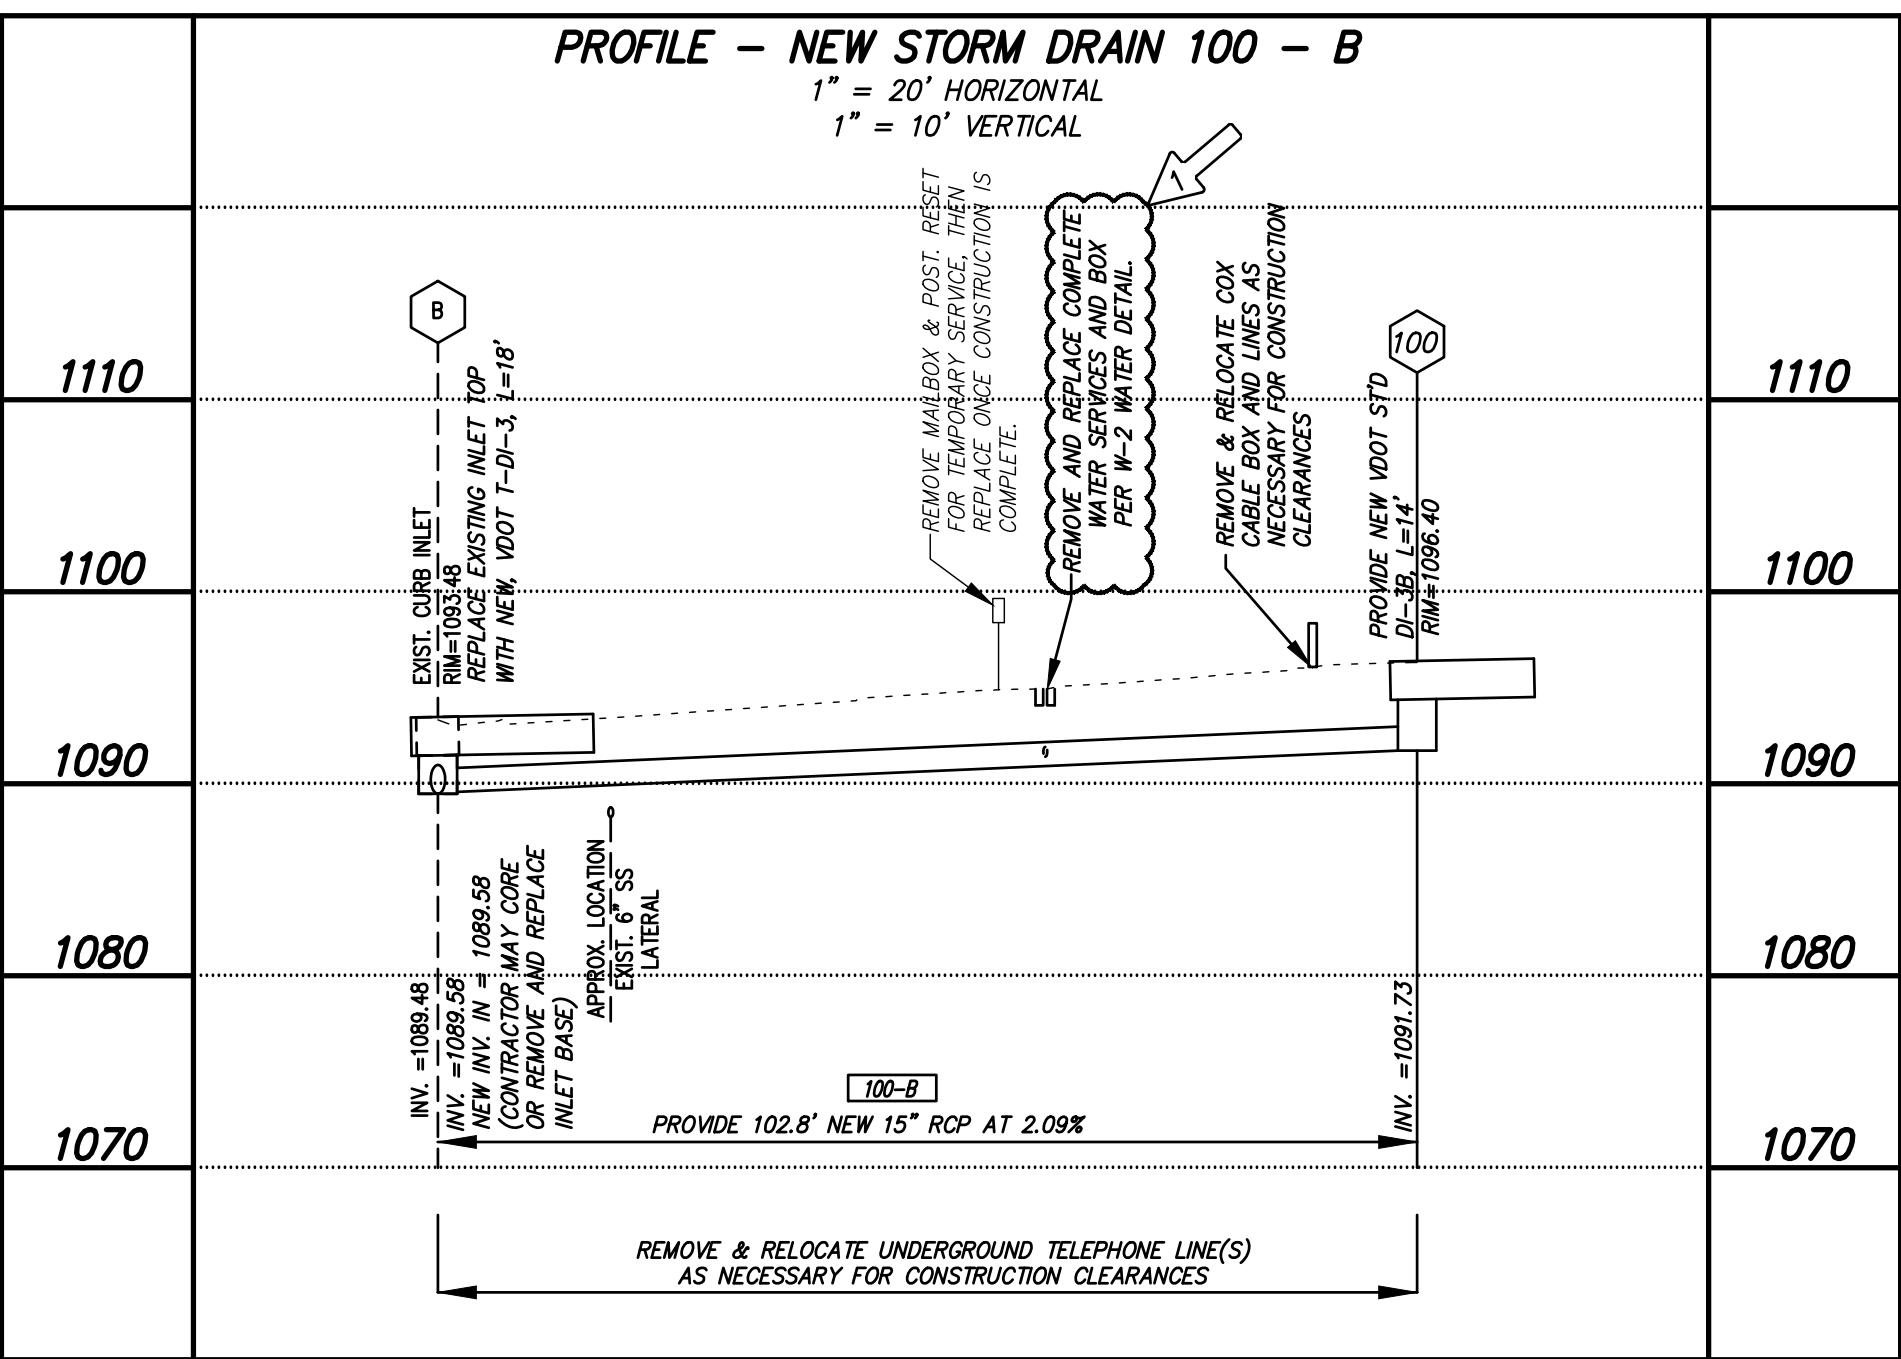


FOR PROFILE PURPOSES, ALL EXISTING WATERLINES ARE ASSUMED TO HAVE THREE FEET OF COVER, CONTRACTOR SHALL VERIFY BY 'POTHOLING' AS REQUIRED PRIOR TO INSTALLATION OF NEW STORM DRAIN SYSTEMS.

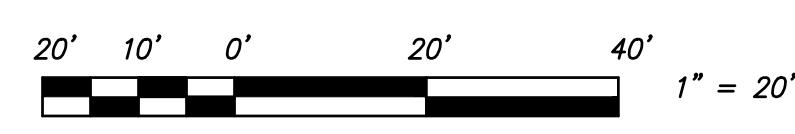

PROFILES - STORM DRAIN FOR TULLY DRIVE / NEIL DRIVE STORM DRAIN PROJECT
PERFORMED FOR ROANOKE COUNTY DEPARTMENT OF STORMWATER OPERATIONS
CATAWBA MAGISTERIAL DISTRICT
COUNTY OF ROANOKE, VIRGINIA


Designed: C.L. White
Drawn: C.L. White
Checked: _____
Date: November 17, 2022
Scale: 1" = 20'
Tax Parcel: (varies-see plan)
Field Book: Roanoke County #9
W.O. No.: 22-0070

CWA
CALDWELL WHITE ASSOCIATES
ENGINEERS / SURVEYORS / PLANNERS
4200 MELROSE AVENUE
P.O. BOX 6260
ROANOKE, VIRGINIA 24017-0260
(540) 366-3400
FAX: (540) 366-8702

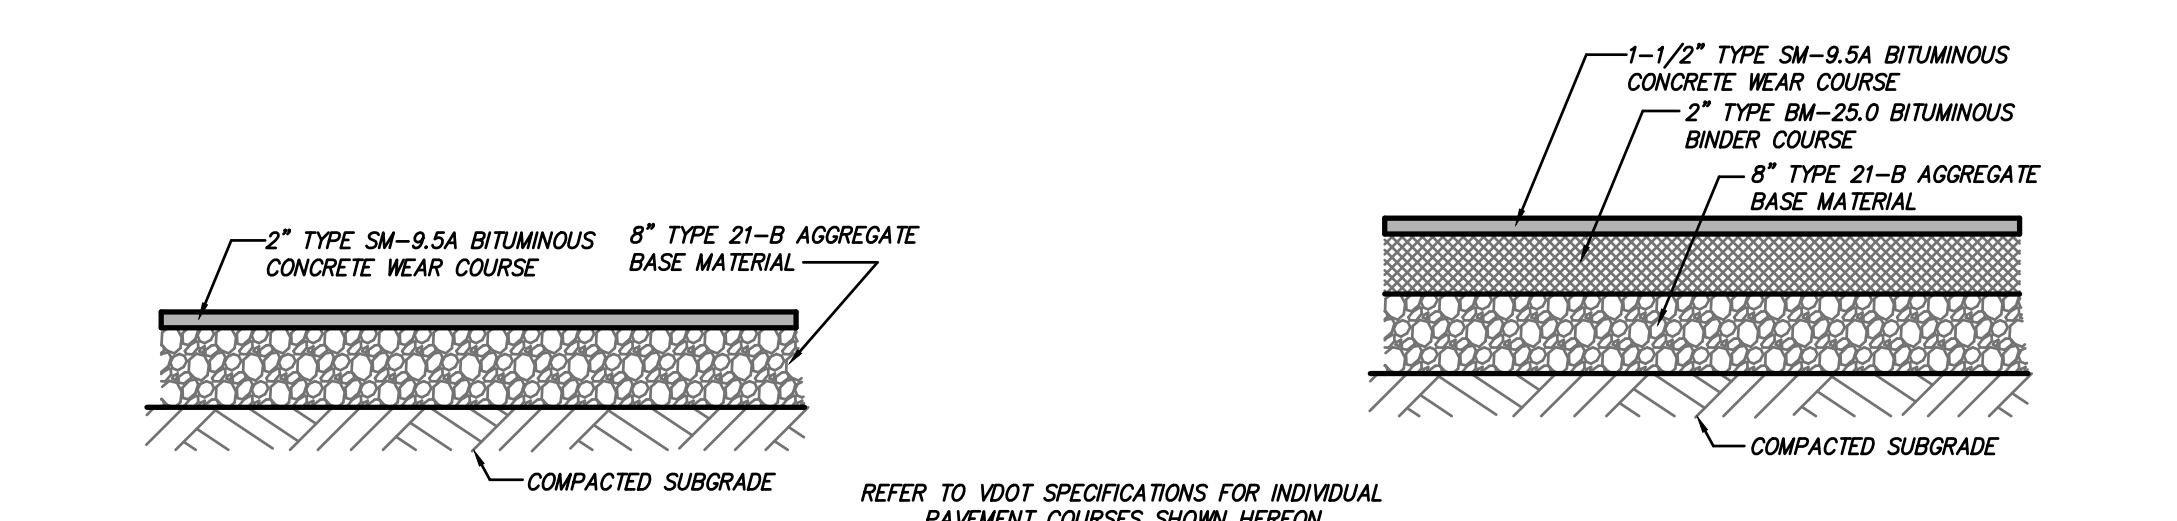


A STANDARD-DUTY BITUMINOUS PAVEMENT
C-07 NO SCALE

B HEAVY-DUTY BITUMINOUS PAVEMENT
C-07 NO SCALE

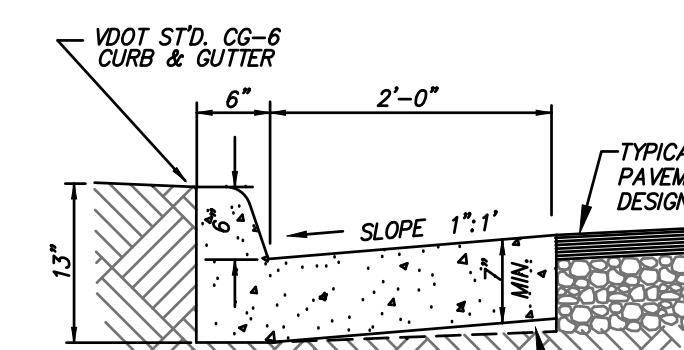


SAW-CUT EXISTING PAVEMENT A MINIMUM OF ONE FOOT BEYOND THE FREE EDGE OF NEW CURB & GUTTER. INSTALL HEAVY DUTY BITUMINOUS PAVEMENT FROM FREE EDGE OF GUTTER TO SAW-CUT. NEW PAVEMENT SHALL MATCH ADJOINING SLOPES. PINCH PAVEMENT JOINT TO PROVIDE AS SEAMLESS A JOINT AS POSSIBLE. SEE DETAIL 'B' THIS SHEET FOR PAVEMENT.


C CONCRETE CURB & GUTTER
C-07 NO SCALE

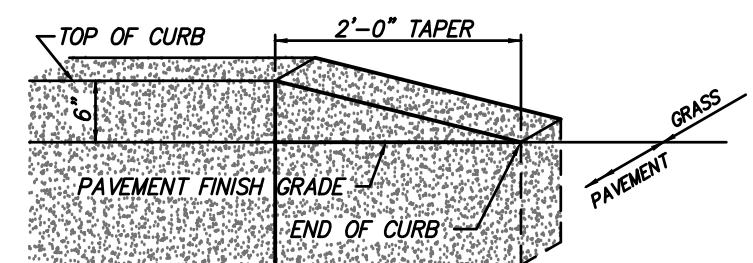

D CURB TAPER
C-07 NO SCALE

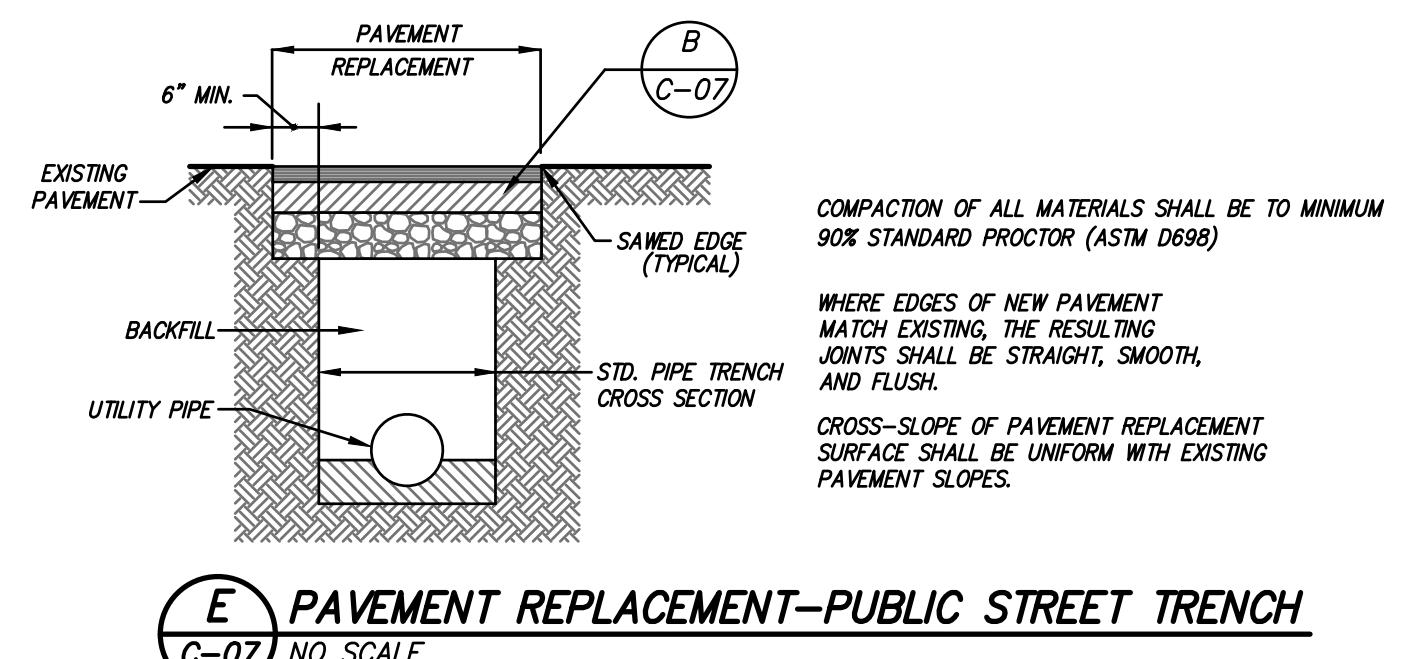

E PAVEMENT REPLACEMENT-PUBLIC STREET TRENCH
C-07 NO SCALE

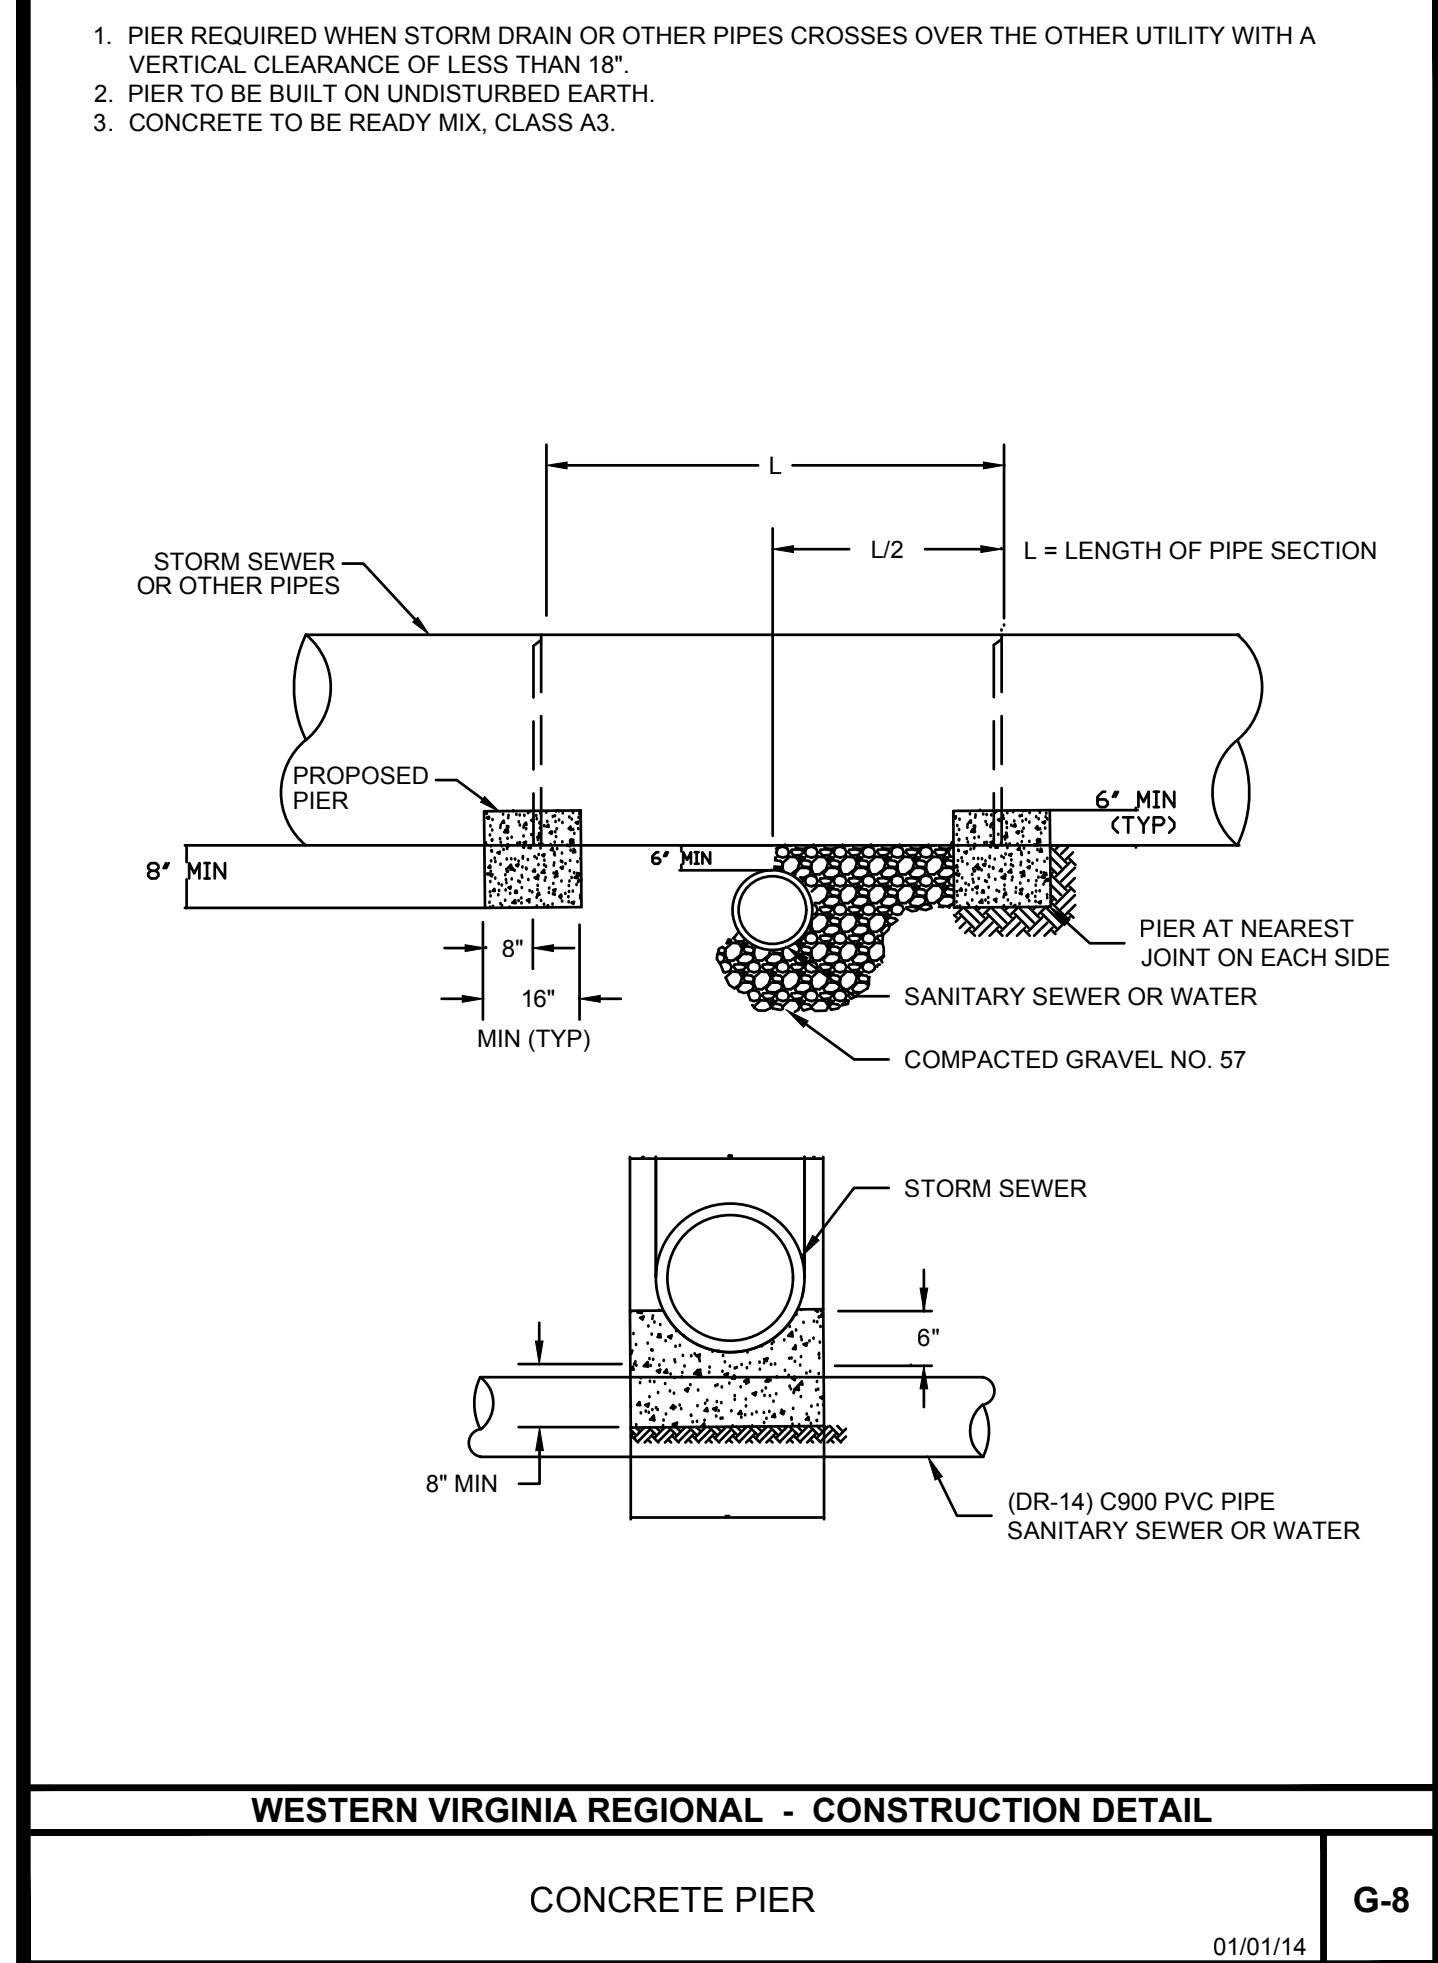


WESTERN VIRGINIA REGIONAL - CONSTRUCTION DETAIL

CONCRETE PIER

G-8

01/01/14

1. SETTER TO BE A.Y. McDONALD 720-215WxD33, FORD VB72-15W-11-33 OR APPROVED EQUAL.
2. SADDLES MUST BE USED WITH ALL PLASTIC & DUCTILE IRON PIPE. SERVICE SADDLES SHALL BE USED IN ACCORDANCE WITH WATER DISTRIBUTION PIPING SPECIFICATION. SERVICE SADDLES FOR PLASTIC PIPE SHALL BE: POWERSEAL 3417, OR 3412AS, ROMAC 2025, OR 306, OR FORD METER FS202 OR FS303. FOR DUCTILE IRON PIPE, USE: POWERSEAL 3413, OR POWERSEAL 3413, ROMAC 202 OR FORD METER 1202.
3. METER SETTER SHALL BE CARSON/MID STATES, INC. PLASTIC METER SETTER, FORD "A" DOMESTIC SERIES FRAME WITH A NICOR DOMESTIC 12.25 CX LID WITH SENSUS RECESS AND VWA LOGO, ADS CORRUGATED HDPE BOX WITH FORD "A" DOMESTIC SERIES FRAME WITH A NICOR DOMESTIC 12.25 CX LID WITH SENSUS RECESS AND VWA LOGO OR APPROVED EQUAL. METER BOX SHALL NOT BE PLACED IN AREAS SUBJECT TO VEHICULAR TRAFFIC. IF TRAFFIC BEARING BOX IS REQUIRED, DESIGN ENGINEER SHALL CONSULT WITH PARTICIPATING UTILITY TO DETERMINE SITE SPECIFIC REQUIREMENTS.
4. CORPORATION STOP SHALL BE FORD FB10004-G-NL, MUELLER B-25008 OR APPROVED EQUAL.
5. SERVICE SHALL BE "K" TYPE COPPER, OR COPPER TUBE SIZE POLYETHYLENE (PE) 4710, SODR-9 (200 psi).
6. WHENEVER SIDEWALK EXISTS OR IS PROPOSED, MODIFY METER LOCATION AS DIRECTED.

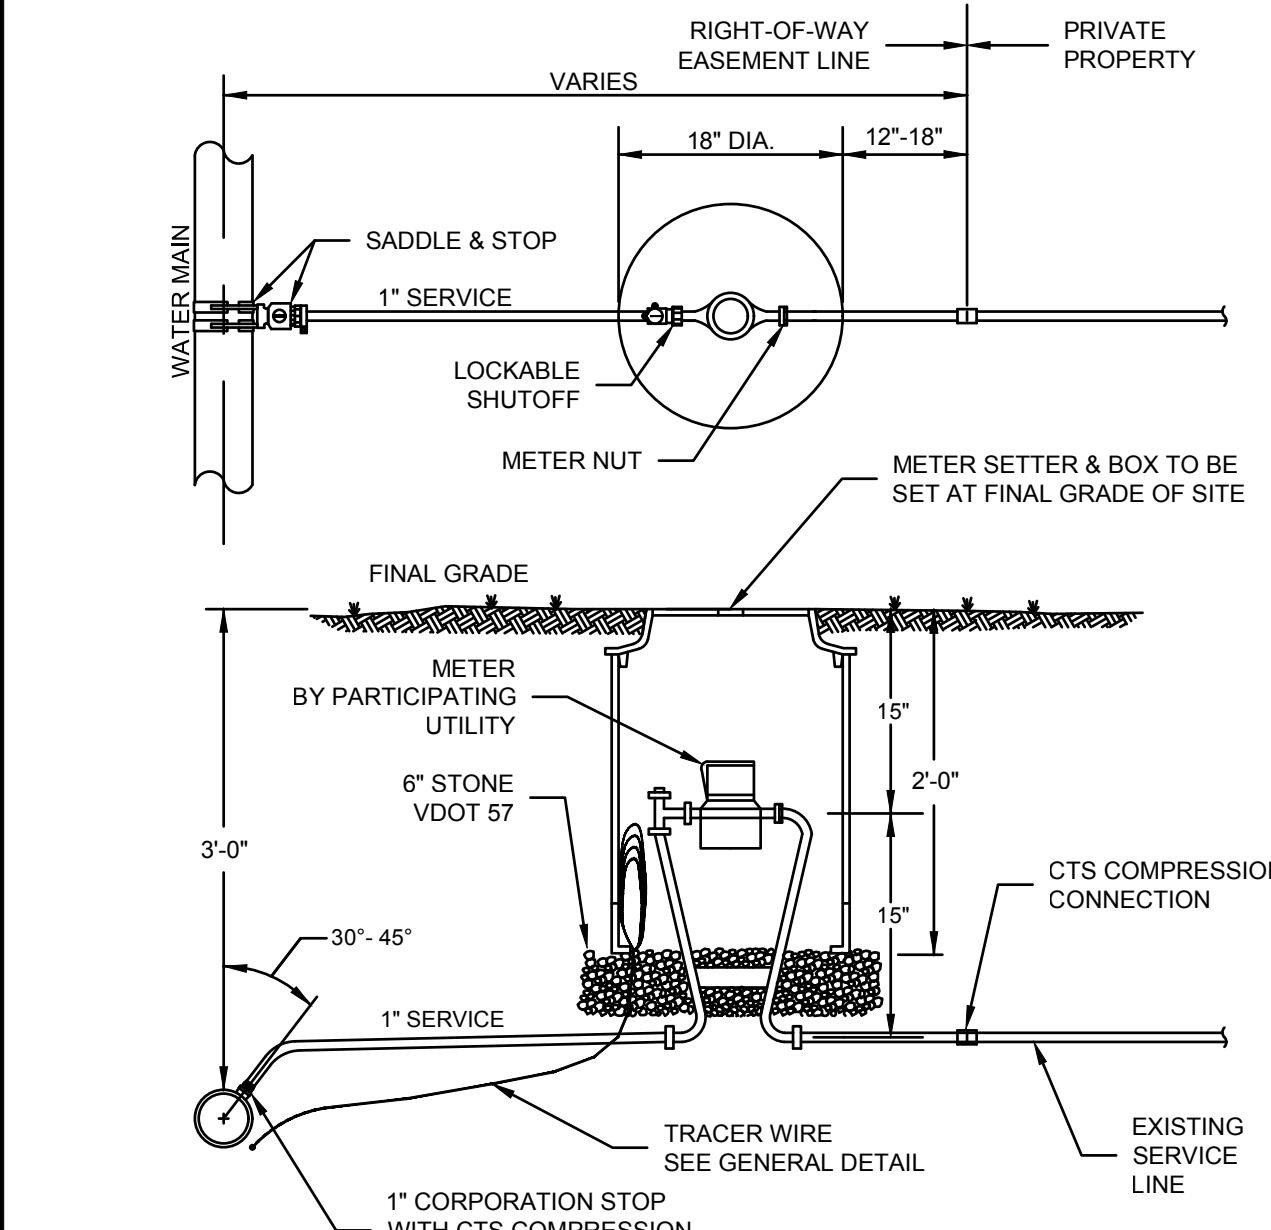


WESTERN VIRGINIA REGIONAL - CONSTRUCTION DETAIL

SINGLE RESIDENTIAL
WATER SERVICE
(REPLACEMENT OF EXISTING SERVICE)

W-2

09/07/17

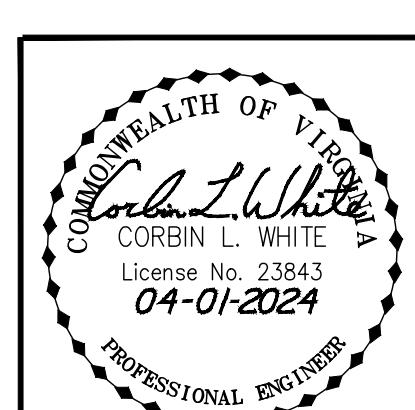

DETAILS - SITE CONSTRUCTION
FOR
TULLY DRIVE / NEIL DRIVE STORM DRAIN PROJECT
PERFORMED FOR
ROANOKE COUNTY DEPARTMENT OF STORMWATER OPERATIONS
CATAWBA MAGISTERIAL DISTRICT
COUNTY OF ROANOKE, VIRGINIA

Designed: C.L. White
Drawn: C.L. White
Checked: _____
Date: November 17, 2022
Scale: As Shown
Tax Parcel: (varies-see plan)
Field Book: Roanoke County #9
W.O. No.: 22-0070

CWA
CALDWELL WHITE ASSOCIATES
ENGINEERS / SURVEYORS / PLANNERS
4200 MELROSE AVENUE
P.O. BOX 6260
ROANOKE, VIRGINIA 24017-0260
(540) 366-3400
FAX: (540) 366-8702

Revised August 23, 2023 Per 1st Municipal Review - C.L. White

SHEET C-07 OF 9

APPROVED, 8/7/2024

SOIL EROSION CONTROL NARRATIVE

PROJECT DESCRIPTION:

The purpose of this project is the construction of supplemental storm drain collection inlets and increased pipe diameters to alleviate localized flooding of residents during large storm events. Also included is the installation of new concrete curb and gutter in the areas of storm drain collection, to keep runoff from jumping to old worn down bituminous curbing and damaging / flooding front yards of residents. Both Tully Drive and Neil Drive drain north to south, and this condition will not be changed by the current project. The project is located generally at the intersection of Tully Drive and Neil Drive in the Catawba Magisterial District of the County of Roanoke, Virginia. The area of land disturbance is estimated to be 0.138 ac (6,031 sq. ft.).

EXISTING SITE CONDITIONS:

The site is currently primarily public street right of way, which is comprised of bituminous pavement and grass shoulders, and drains as described above. The subject site lies within "Zone X" as shown on FEMA flood insurance rate maps (FIRM map number 51161C0134G, effective date 09/28/2007).

EXHIBIT RUTTING, PUMPING, OR EXCESSIVE LATERAL MOVEMENT OF SOILS:

There have been no comprehensive on-site geotechnical investigations performed. The USDA Web Soil Survey identifies the soils in the area of proposed construction as belonging to the soil unit group shown below and on the plan. The contractor shall notify the engineer immediately upon discovery of subsurface conditions that exhibit rutting, pumping, or excessive lateral movement of soils, as these may be indicative of unsuitable subgrade conditions.

UNIT CODE	NAME	CHARACTERISTICS	DEPTH TO RESTRICTIVE FEATURE	EROSION POTENTIAL	DEPTH TO SEASONAL HIGH WATER	HYDROLOGIC SOIL GROUP
37B	SEQUOIA SILT LOAM, 2 TO 7 PERCENT SLOPES	SILT LOAMS, SILT CLAYS	20 TO 40 INCHES TO PARALITHIC BEDROCK	MODERATE	> 80 INCHES	C

ADJACENT PROPERTY:

The project site is bounded to all sides by residential uses, see plan sheets for individual property owners of record.

OFF-SITE AREAS:

It is expected there will be export material from pipe trench spoils. The contractor shall waste these materials at a permitted off-site location.

Critical Areas

The following areas have the potential for serious soil erosion or warrant additional attention by the contractor. The contractor shall pay particular attention to work in and stabilization of these areas:

- Maintenance of silt fence barriers and inlet protective measures will be critical to ensure sediment laden runoff is properly filtered prior to entering the storm drain system, and to protect the downgradient areas from sedimentation.
- Existing and new storm structures shall be protected properly. This is the most important and usually the least protected point of sediment collection. It is critical that the structures are adequately protected against sedimentation, which will ensure minimal cleaning efforts of the contractor on the existing and new storm drain pipeworks.

Stormwater Runoff:

See notes, sheet C-04 concerning runoff quantity and quality.

Erosion and Sediment Control Measures:

Unless otherwise indicated, all vegetative and structural erosion and sediment control practices shall be constructed and maintained according to the minimum standards and specifications of the "Virginia Erosion and Sediment Control Handbook", Third Edition.

1. Regardless of future development plans, the contractor shall immediately install erosion and sediment control devices as shown on the plans. This work shall be coordinated in order to protect areas from the work which is to follow. Control centers, roads, and areas of construction herein shall be considered as permanent.

2. Following completion of the permanent contractor, the stormwater contractor shall begin earthwork operations. The contractor shall immediately proceed with clearing, grubbing, and grading operations. Denuded areas indicated on these plans to receive permanent seeding (STD & SPEC 3.32) shall be seeded within seven (7) days after final grading, and shall be in strict accordance with the "Virginia Erosion and Sediment Control Handbook", Third Edition.

3. In general, all erosion and sediment control measures shall be inspected weekly and after each significant rainfall in particular:

- A. The construction entrance (STD & SPEC 3.02) shall be maintained in a condition to prevent tracking or flow of mud onto public right-of-ways.
- B. All silt fence barriers (STD & SPEC 3.05) shall be checked regularly for undermining and sediment buildup.

C. Inlet protection measures shall be inspected to insure filtration measures are effective, and are not choked with silt, clean as necessary to prevent excessive ponding.

D. All seeded areas shall be checked regularly to see that a good stand is maintained. Areas shall be fertilized and reseeded as needed.

4. The soil erosion control measures installed for this contract shall remain in place until removal is approved by the county of Roanoke inspector, at which time it shall be the sitework contractor's responsibility to remove all temporary measures from the site unless, otherwise required herein, and stabilize all disturbed areas in accordance with these plans.

Maintenance of Erosion and Sediment Control Measures:

- Silt fence barriers shall be inspected daily and cleaned or replaced as required. Clean silt fence when silt measures one-half the height of the fence, or as required.

- Storm drain collection points shall be protected using inlet protection measures as outlined herein. The contractor is responsible for removal of excess sediment from the storm drain structures at all times until the project is completed and turned over to owner.

- Public streets and adjacent paved areas shall remain in a dust and mud-free condition throughout the construction period. Should off-site sedimentation occur, it is the contractor's responsibility to return all affected areas to a condition equal to or better than the original condition, at no added cost to the owner.

- Disturbed areas that are not permanently stabilized within fourteen (14) days shall be temporarily seeded in accordance with standard and specification 3.31 of the Virginia Erosion and Sediment Control Handbook, latest edition.

- All protective measures which pertain to, or include cut and fill slopes (silt fence, diversion dikes, etc.) shall be installed and maintained as the slopes come to grade. Additional diversion dikes will be required to protect disturbed areas, until such time that the storm drain system is in place, and functionally protected from sediment infiltration. Temporary seeding of slopes is to be performed on a weekly basis, unless the slopes are to final grade. Slopes at final grade are to be permanently seeded within seven days of reaching final grade.

The contractor is required to provide and maintain all erosion control measures at their optimum performance, such that adjoining areas and drainageways are provided the best available protection at every phase of construction. It is imperative that sediment transfer from this site is minimized.

Permanent Stabilization:

Upon achieving finish grade elevations, all disturbed areas not to receive hard surfacing shall be permanently seeded (STD & SPEC 3.32) as outlined herein and on the soil erosion control plan and detail sheets, unless other stabilization measures such as landscape mulching are provided.

Maintenance:

The responsible land disturber on record with the county for this project is responsible for implementation, maintenance, and removal of all erosion control measures, as applicable.

All measures required herein shall be maintained as outlined in "critical areas" and "erosion and sediment control measures" sections above.

General Comments:

1. The sitework contractor shall be responsible for the installation and maintenance of all erosion and sediment control practices.

2. The county of Roanoke or their authorized agent reserves the right to add to, delete or otherwise change erosion control devices as may be deemed necessary, by written notification to the contractor.

3. No work shall proceed on the site until the proper authorization or permit has been obtained from the county of Roanoke.

4. The engineer, Caldwell White Associates, assumes no responsibility for any work being performed.

STATE IMPOSED MINIMUM STANDARDS

The following standards are to be provided or addressed on every development project exceeding 10,000 s.f. in area of disturbance. These standards are considered a minimum and may require additional measures as deemed necessary by the local approving authority or the consulting engineer.

No.	Criteria, Technique or Method	Remarks
1	Permanent or temporary soil stabilization shall be applied to denuded areas within seven (7) days after final grade has been reached on any portion of the site. Temporary soil stabilization shall be applied within seven (7) days to denuded areas that may be at final grade but will remain dormant (undisturbed) for longer than fourteen (14) days. Permanent stabilization shall be applied to areas that are to be left dormant for more than one (1) year.	See "Permanent Seeding" and "Temporary Seeding" requirements, Sheets C-05 and C-09
2	During construction of the project, soil stockpiles shall be stabilized or protected with sediment trapping measures. The contractor is responsible for the temporary protection and permanent stabilization of all soil stockpiles on site as well as soil intentionally transported from the project site.	Not applicable - no stockpiles anticipated
3	A permanent vegetative cover shall be established on denuded areas not otherwise stabilized. Permanent vegetation shall not be considered established until a ground cover is achieved that, in the opinion of the local program administrator or designated agent, is uniform, mature enough to survive and will inhibit erosion.	Self explanatory - refer to the seeding specifications herein.
4	sediment basins and traps, perimeter dikes, sediment barriers and other measures intended to trap sediment shall be constructed as a first step in any land-disturbing activity and shall be made functional before upslope land disturbance takes place.	Self explanatory - refer to silt fence barrier requirements
5	Stabilization methods shall be applied to earthen structures such as dams, dikes and diversions immediately after installation.	Not applicable to subject development
6	sediment traps and basins shall be designed and constructed based upon the total drainage area to be served by the trap or basin.	Not applicable to subject development
7	Cut and fill slopes shall be constructed in a manner that will minimize erosion. slopes that are found to be eroding excessively within one (1) year of permanent stabilization shall be provided with additional slope stabilization measures until the problem is corrected.	Not applicable to subject development
8	Concentrated runoff shall not flow down cut or fill slopes unless contained within an adequate temporary or permanent channel, flume or slope drain structure.	Self-explanatory
9	Whenever water seeps from a slope face, adequate drainage or other protection shall be provided.	Report evidence of seeps to engineer immediately upon discovery. Additional measures may be required.
10	All storm sewer inlets that are made operable during construction shall be protected so that sediment-laden water cannot enter the conveyance system without first being filtered or otherwise treated to remove sediment.	Provide inlet protection as outlined on the plan
11	Before newly constructed stormwater conveyance channels are made operational, adequate outlet protection and any required temporary or permanent channel lining shall be installed in both the conveyance channel and receiving channel.	Not applicable to subject development
12	When work in a live watercourse is performed, precautions shall be taken to minimize encroachment, control sediment transport and stabilize the work area to the greatest extent possible during construction. Nonerodible material shall be used for the construction of causeways and cofferdams. Earthen fill may be used for these structures if armored by nonerodible cover materials.	Not applicable to subject development
13	When a live watercourse must be crossed by construction vehicles more than twice in any six (6) month period, a temporary stream crossing constructed of nonerodible material.	Not applicable to subject development
14	All applicable federal, state and local regulations pertaining to working in or crossing live watercourses shall be met. The beds and banks of any watercourse shall be stabilized immediately after work in the watercourse is completed.	Not applicable to subject development
15	The beds and banks of a watercourse shall be stabilized immediately after work in the watercourse is completed.	Not applicable to subject development
16	Underground utility lines shall be installed in accordance with the following standards in addition to other applicable criteria: 1) no more than 500 linear feet of any trench may be opened at one time, 2) excavated material shall be placed on the uphill side of trenches, 3) effluent from dewatering operations shall be filtered or passed through an approved sediment trapping device, or both, and used for backfilling trenches shall be properly compacted in order to minimize erosion and promote stabilization, 4) reestablishment shall be accomplished in accordance with these regulations, 5) applicable safety regulations shall be complied with.	Self-explanatory. New utility line construction shall conform to these requirements.
17	Where construction vehicle access routes intersect paved or public roads, provisions shall be made to minimize the transport of sediment by vehicular tracking onto the paved surface, where sediment is transported onto a paved or public road surface, the road surface shall be cleaned thoroughly at the end of each day. sediment shall be removed from the roads by shoveling or sweeping and transported to a sediment control disposal area. street washing shall be allowed only after sediment is removed in this manner.	Given that most of the work will be performed on or adjacent to paved street, no formal construction entrance is warranted.
18	All temporary erosion and sediment control measures shall be removed within thirty (30) days after final site stabilization or after the temporary measures are no longer needed, unless otherwise authorized by the local program administrator. Trapped sediment and the disturbed soil areas resulting from the disposition of temporary measures shall be permanently stabilized to prevent further erosion and sedimentation.	Removal of temporary measures shall be in accordance with MS-18.
19	Properties and waterways downstream from development sites shall be protected from sediment deposition, erosion, and damage due to increases in volume, velocity and peak flow rate of stormwater runoff for the stated frequency storm. Stormwater management in accordance with the state standard and criteria, stream protection and relocation projects that incorporate natural channels and design concepts are not man-made channels and shall be exempt from any flow rate capacity and velocity requirements for natural or man-made channels. A concentrated stormwater runoff leaving a development site shall be discharged directly into an adequate natural or man-made receiving channel or storm sewer system. For those sites where runoff is discharged into a pipe or pipe system, downstream stability analyses at the outfall of the pipe or pipe system shall be performed. b. adequacy of all channels and pipes shall be verified in the following manner: (1) the applicant shall demonstrate that the total drainage area at the point of analysis within the channel is one hundred times greater than the contributing drainage area of the project in question, or (2) a natural channel shall be analyzed by the use of a two-year storm to verify that stormwater will not overtop channel banks or cause erosion of channel bed or banks. (b) all previously developed channels and structures shall be analyzed by the use of a two-year storm to verify that stormwater will not overtop channel banks or cause erosion of channel bed or banks, and (c) previously constructed man-made channels or pipes are not adequate, the applicant shall (1) improve the channels to a condition where a ten-year storm will not overtop the banks and a two-year storm will not cause erosion to the channel bed or banks, or (2) improve the pipe or pipe system to a condition where the ten-year storm is contained within the appurtenances; or (3) develop a site design that will not cause the pre-development peak runoff rate from a ten-year storm to increase when runoff outfalls into a natural channel or will not cause the pre-development peak runoff rate from a ten-year storm to increase when runoff outfalls into a man-made channel or (4) provide a combination of channel improvement, stormwater detention or other measures which is satisfactory to the plan-approving authority to prevent downstream erosion. d. the applicant shall provide a permanent or temporary outlet to receive stormwater runoff from the site. the outlet shall be located in a receiving channel, and energy dissipators shall be placed at the outfall of all detention facilities as the person responsible for performing the maintenance. g. outfall from a detention facility shall be discharged to a receiving channel, and energy dissipators shall be placed at the receiving channel. h. all on-site channels must be verified to be adequate. i. increased volumes of sheet flow that may cause erosion or sedimentation on adjacent property shall be diverted to a stable outlet, adequate channel pipe or pipe system, or to a detention facility. i. in applying these stormwater management criteria, individual lots or parcels in a residential, commercial or industrial development or other construction project, or developments of similar size, may be grouped together and analyzed as a single entity. the developer or owner of the development or project shall be responsible for the maintenance of the detention facility and the person responsible for performing the maintenance. j. the developer or owner of the development or project shall be responsible for the maintenance of the detention facility and the person responsible for performing the maintenance. k. all measures used to protect properties and waterways shall be employed in a manner which minimizes impacts on the physical, chemical and biological integrity of rivers, streams and other waters of the state. l. any plan approved prior to july 1, 2014, that provides for stormwater management that addresses any flow rate capacity and velocity requirements for natural or man-made channels shall be exempt from any flow rate capacity and velocity requirements for natural or man-made channels that are defined in any regulations promulgated pursuant to s. 101-562 or 101-570 of the act. m. for plans approved on and after july 1, 2014, the flow rate capacity and velocity requirements of s. 101-561 of the act and this subsection shall be satisfied by compliance with water quantity requirements in the stormwater management act (s. 101-603.2 et seq. of the code of virginia) and attendant regulations, unless such land-disturbing activities are in accordance with 4vac50-60-48 of the virginia stormwater management program (vsm) permit regulations. n. compliance with the water quantity minimum standards set out in 4vac50-60-66 of the virginia stormwater management program (vsm) permit regulations shall be deemed to satisfy the requirements of minimum standard 19.	See notes, sheet C-04 concerning runoff quantity and quality.

VESCH TABLE 6-1: GENERAL EROSION AND SEDIMENT CONTROL NOTES:

ES-1: UNLESS OTHERWISE INDICATED, ALL VEGETATIVE AND STRUCTURAL EROSION AND SEDIMENT CONTROL PRACTICES WILL BE CONSTRUCTED AND MAINTAINED ACCORDING TO MINIMUM STANDARDS AND SPECIFICATIONS OF THE VIRGINIA EROSION AND SEDIMENT CONTROL HANDBOOK AND VIRGINIA REGULATIONS 4VAC50-30 EROSION AND SEDIMENT CONTROL REGULATIONS

ES-2: THE PLAN APPROVING AUTHORITY MUST BE NOTIFIED ONE WEEK PRIOR TO THE PRE-CONSTRUCTION CONFERENCE, ONE WEEK PRIOR TO THE COMMENCEMENT OF LAND DISTURBING ACTIVITY, AND ONE WEEK PRIOR TO THE FINAL INSPECTION.

ES-3: ALL EROSION AND SEDIMENT CONTROL MEASURES ARE TO BE PLACED PRIOR TO OR AS THE FIRST STEP IN CLEARING.

ES-4: A COPY OF THE APPROVED EROSION AND SEDIMENT CONTROL PLAN SHALL BE MAINTAINED ON THE SITE AT ALL TIMES.

ES-5: PRIOR TO COMMENCING LAND DISTURBING ACTIVITIES IN AREAS OTHER THAN INDICATED ON THE PLANS (INCLUDING, BUT NOT LIMITED TO, OFF-SITE BORROW OR WASTE AREAS), THE CONTRACTOR SHALL SUBMIT A SUPPLEMENTAL EROSION CONTROL PLAN TO THE OWNER FOR REVIEW AND APPROVAL BY THE PLAN APPROVING AUTHORITY.

ES-6: THE CONTRACTOR IS RESPONSIBLE FOR INSTALLATION OF ANY ADDITIONAL EROSION CONTROL MEASURES NECESSARY TO PREVENT EROSION AND SEDIMENTATION AS DETERMINED BY THE PLAN APPROVING AUTHORITY.

ES-7: ALL DISTURBED AREAS ARE TO DRAIN TO APPROVED SEDIMENT CONTROL MEASURES AT ALL TIMES DURING LAND DISTURBING ACTIVITIES AND DURING SITE DEVELOPMENT UNTIL FINAL STABILIZATION IS ACHIEVED.

ES-8: DURING Dewatering operations, water will be pumped into an approved filtering device.

ES-9: THE CONTRACTOR SHALL INSPECT ALL EROSION CONTROL MEASURES PERIODICALLY AND AFTER EACH RUN-OFF PRODUCING RAINFALL EVENT. ANY NECESSARY REPAIRS OR CLEANUP TO MAINTAIN THE EFFECTIVENESS OF THE EROSION CONTROL DEVICES SHALL BE MADE IMMEDIATELY.

CONSTRUCTION SEQUENCING - SITE SPECIFIC

DURING ALL PHASES OF THIS PROJECT, THE CONTRACTOR SHALL LIMIT LAND DISTURBANCE TO THE AREAS SHOWN HEREIN. ANY LAND DISTURBANCE, SOIL COMPACTION, OR ANY TYPE OF IMPACT TO THE SOILS BEYOND THE APPROVED LIMITS OF CONSTRUCTION MAY RESULT IN A STOP WORK ORDER, NEW DESIGN REQUIREMENTS, ADDITIONAL REVIEW TIME, AND ADDITIONAL CONSTRUCTION REQUIREMENTS.

1. PRIOR TO ANY WORK, THE CONTRACTOR SHALL COORDINATE WITH ALL UNDERGROUND CABLE UTILITY OWNERS, TO DETERMINE THE SCHEDULE FOR RELOCATION OF EXISTING UTILITIES BEYOND THE AREAS OF WORK NECESSARY FOR INSTALLATION OF THE NEW STORM DRAIN SYSTEMS.

2. PRIOR TO ANY STORM DRAIN WORK COMMENCING, THE CONTRACTOR SHALL INSTALL SOIL EROSION CONTROL BARRIERS SHOWN HEREIN.

3. THE FIRST STEP SHALL BE TO INSTALL THE OUTLET PROTECTION AT THE MOST DOWNSTREAM END OF THE PROJECT, SUCH THAT ANY CATASTROPHIC RAINFALL EVENTS WILL FLOW ACROSS A PROTECTED AREA PRIOR TO LEAVING THE CONSTRUCTION SITE.

4. STORM DRAIN INSTALLATION SHALL PROCEED IN AN UPSTREAM DIRECTION.

5. AT THE END OF EACH DAY'S WORK, THERE SHALL BE CONTINUOUS PIPE RUNS TO DRAIN ALL IN-PLACE INLET STRUCTURES.

6. UPON COMPLETION OF THE MOST DOWNSTREAM PIPE RUN, THE CONTRACTOR SHALL FINE-GRADE, PERMANENTLY SEED AND STRAW-MULCH THE REAR YARD AREA, TO ACQUIRE SUBSTANTIAL STABILIZATION AS SOON AS POSSIBLE.

7. UPON COMPLETION OF ALL NEW AND UPSIZED PIPES AND INLET STRUCTURES, THE CONTRACTOR SHALL PROCEED WITH INSTALLATION OF NEW CONCRETE CURB AND GUTTER, CONSTRUCTION OF NEW CONCRETE RESIDENTIAL ENTRANCES, AND PAVEMENT REPL

